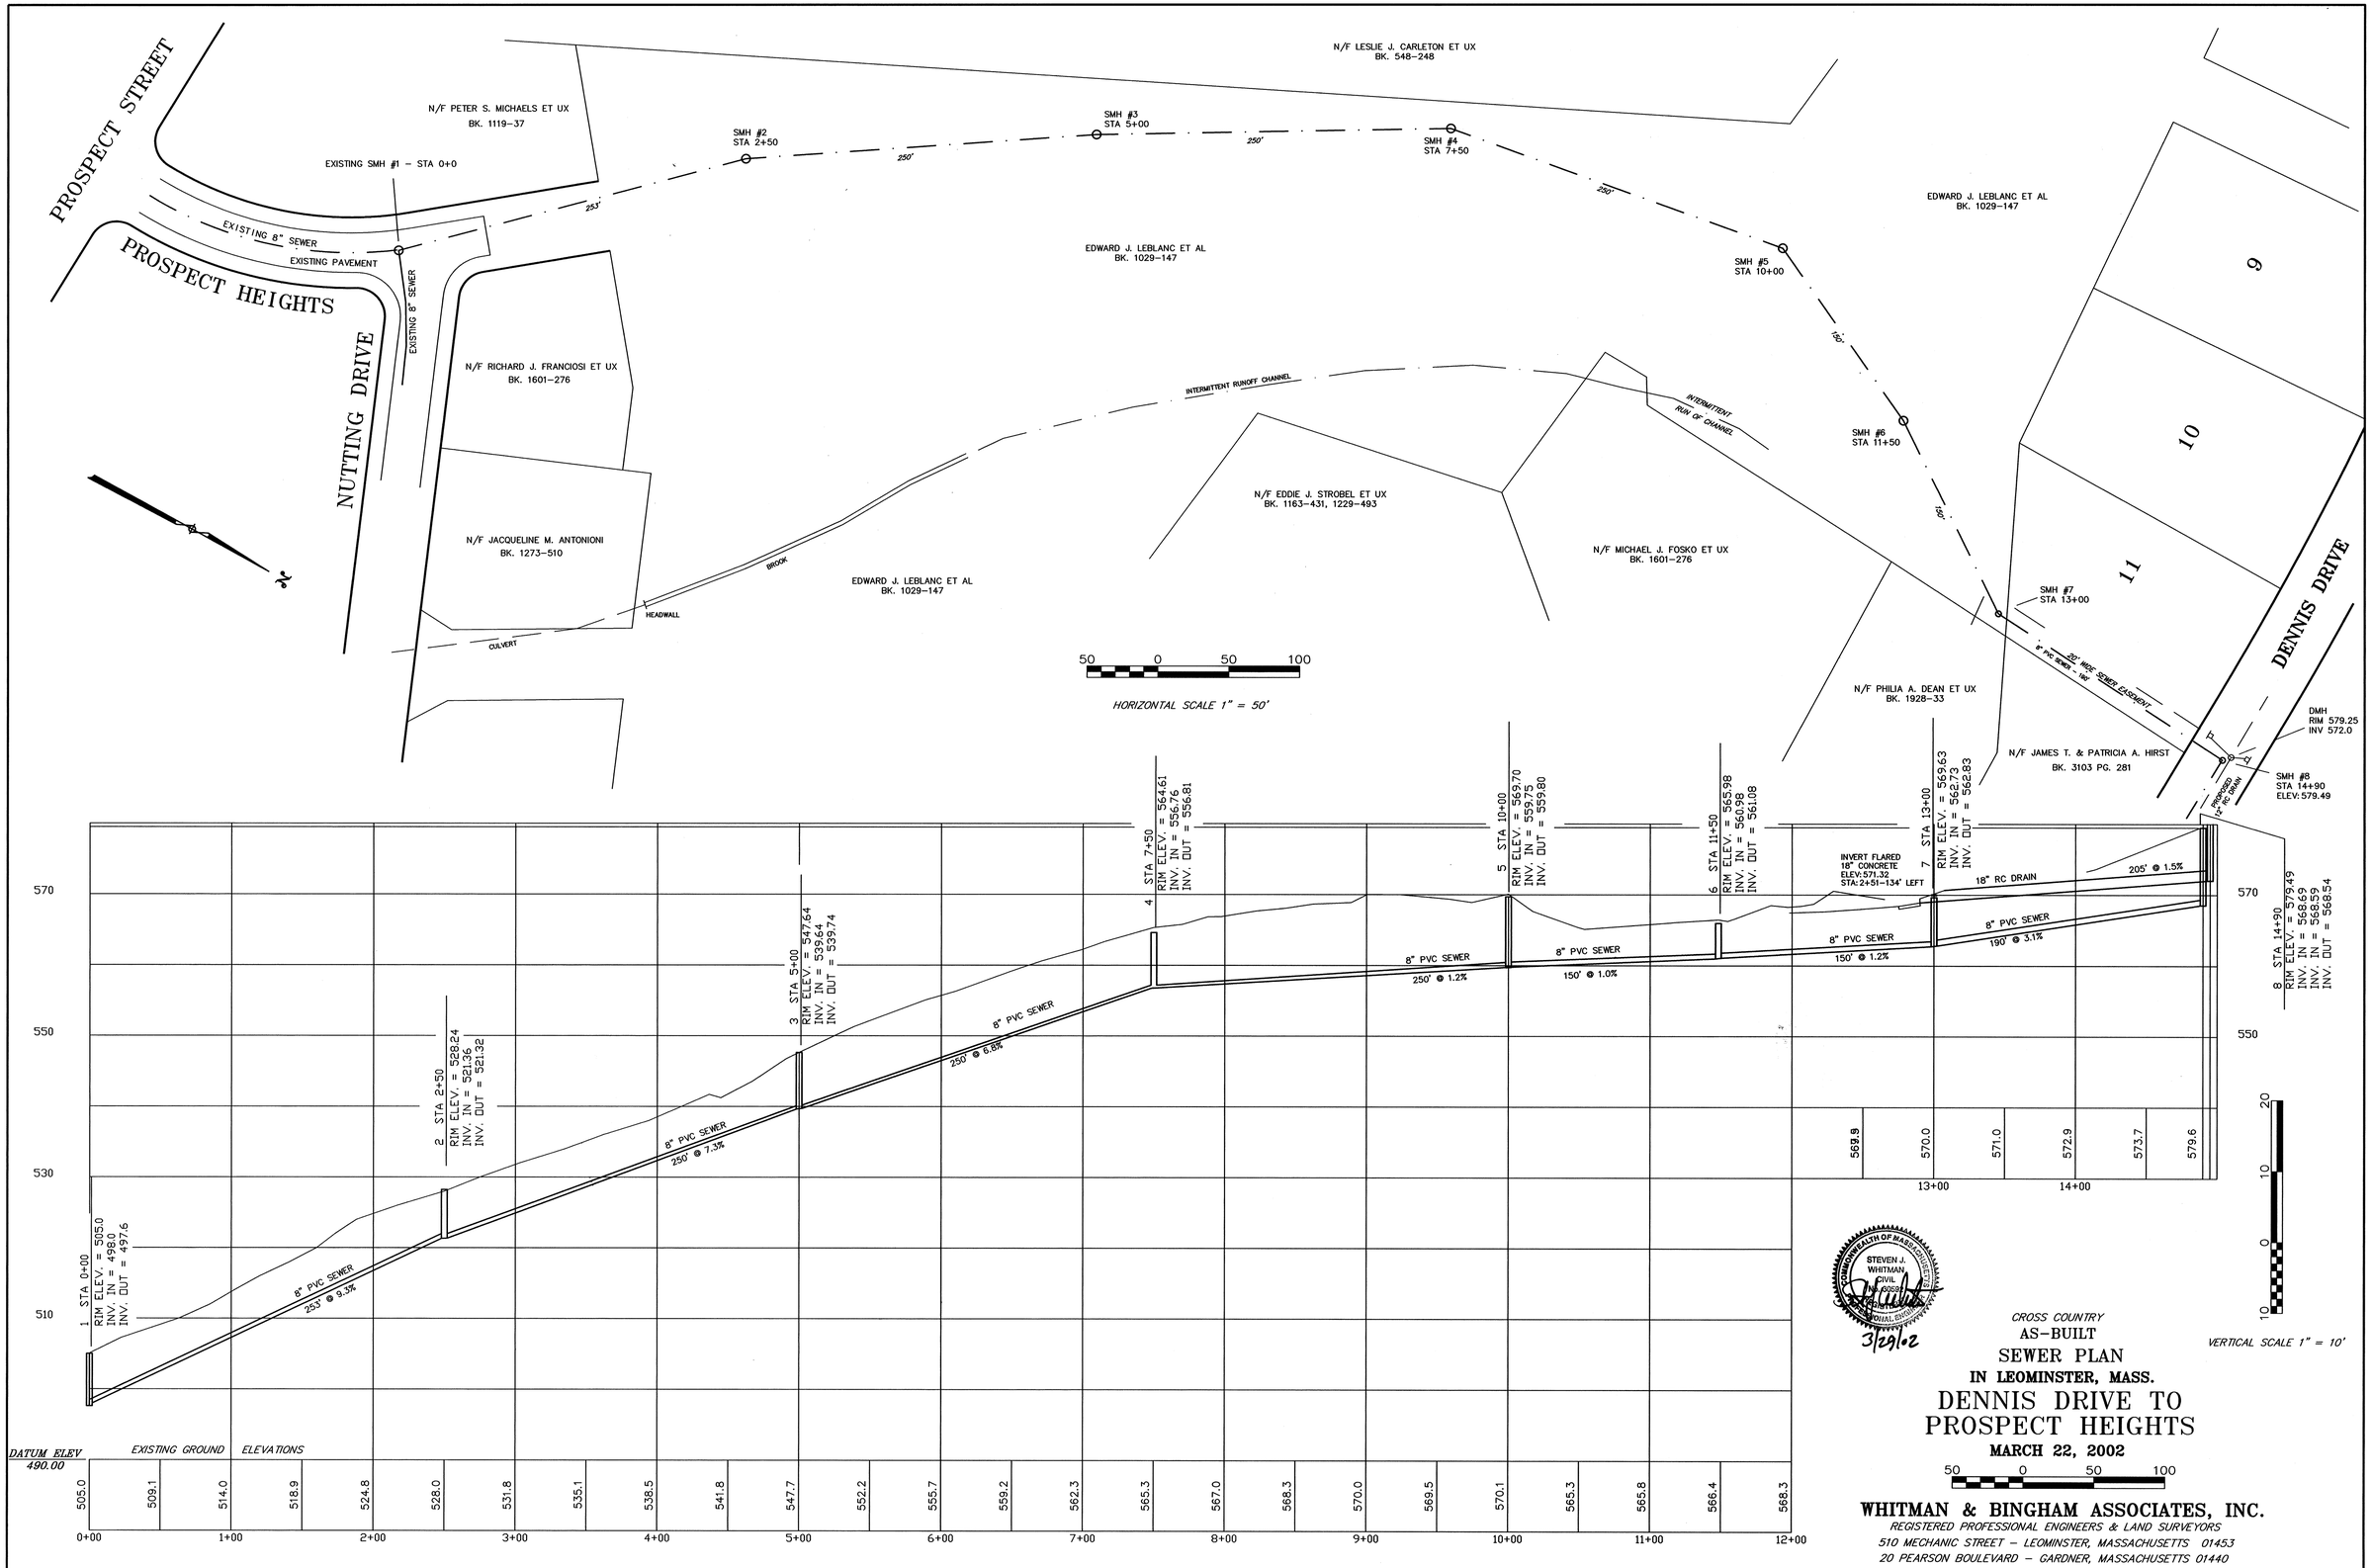

CROSS COUNTRY
AS-BUILT
SEWER PLAN
IN LEOMINSTER, MASS.
DENNIS DRIVE TO
PROSPECT HEIGHTS
MARCH 22, 2002

50 0 50 100

WHITMAN & BINGHAM ASSOCIATES, INC.
REGISTERED PROFESSIONAL ENGINEERS & LAND SURVEYORS
510 MECHANIC STREET - LEOMINSTER, MASSACHUSETTS 01453
20 PEARSON BOULEVARD - GARDNER, MASSACHUSETTS 01440

19-D-31