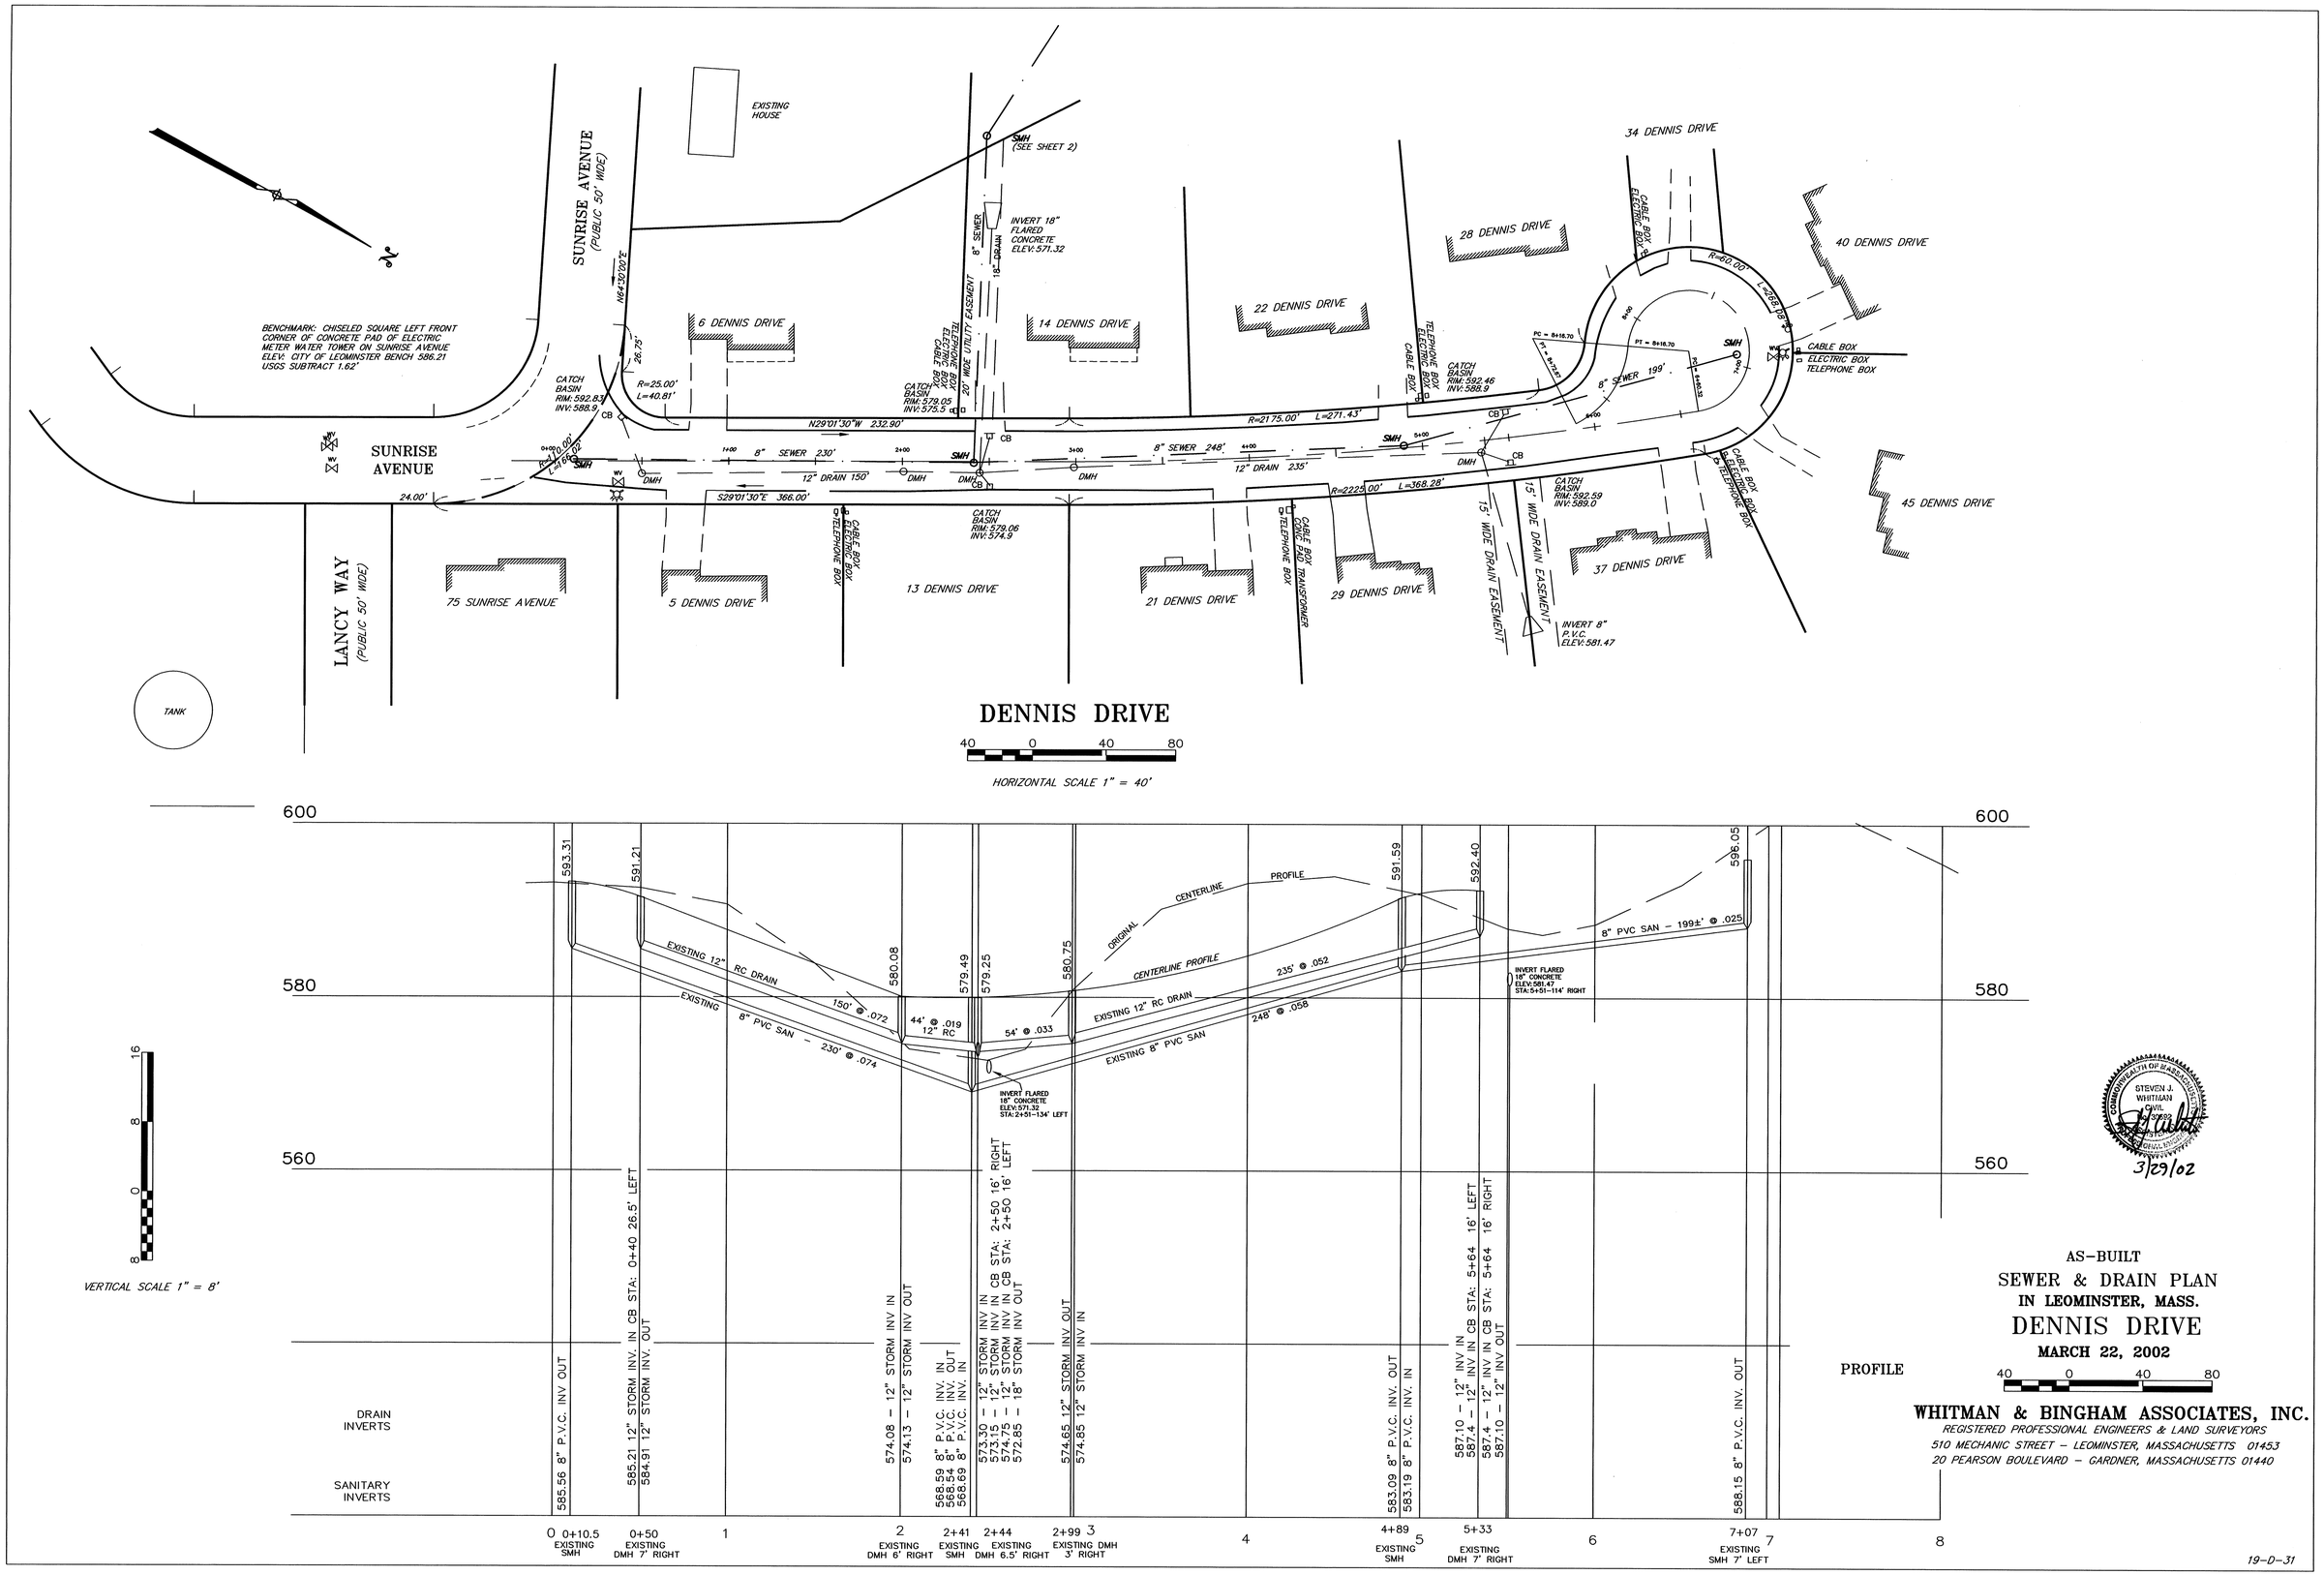

AS-BUILT
SEWER & DRAIN PLAN
IN LEOMINSTER, MASS.
DENNIS DRIVE
MARCH 22, 2002

40 0 40 80

WHITMAN & BINGHAM ASSOCIATES, INC.
REGISTERED PROFESSIONAL ENGINEERS & LAND SURVEYORS
510 MECHANIC STREET - LEOMINSTER, MASSACHUSETTS 01453
20 PEARSON BOULEVARD - GARDNER, MASSACHUSETTS 01440

19-D-31