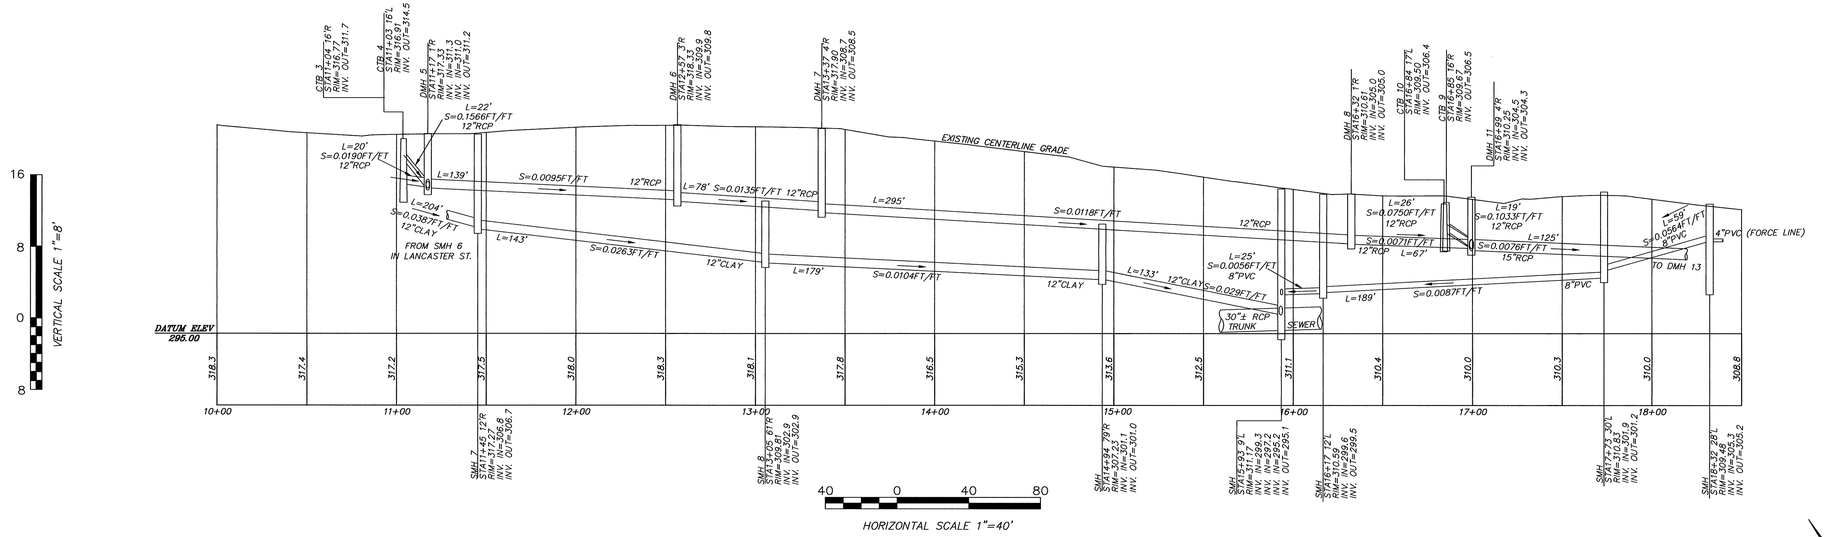

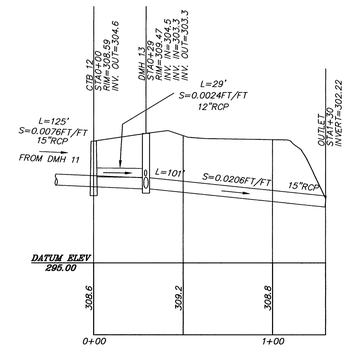

DMH 13 TO BASIN INLET

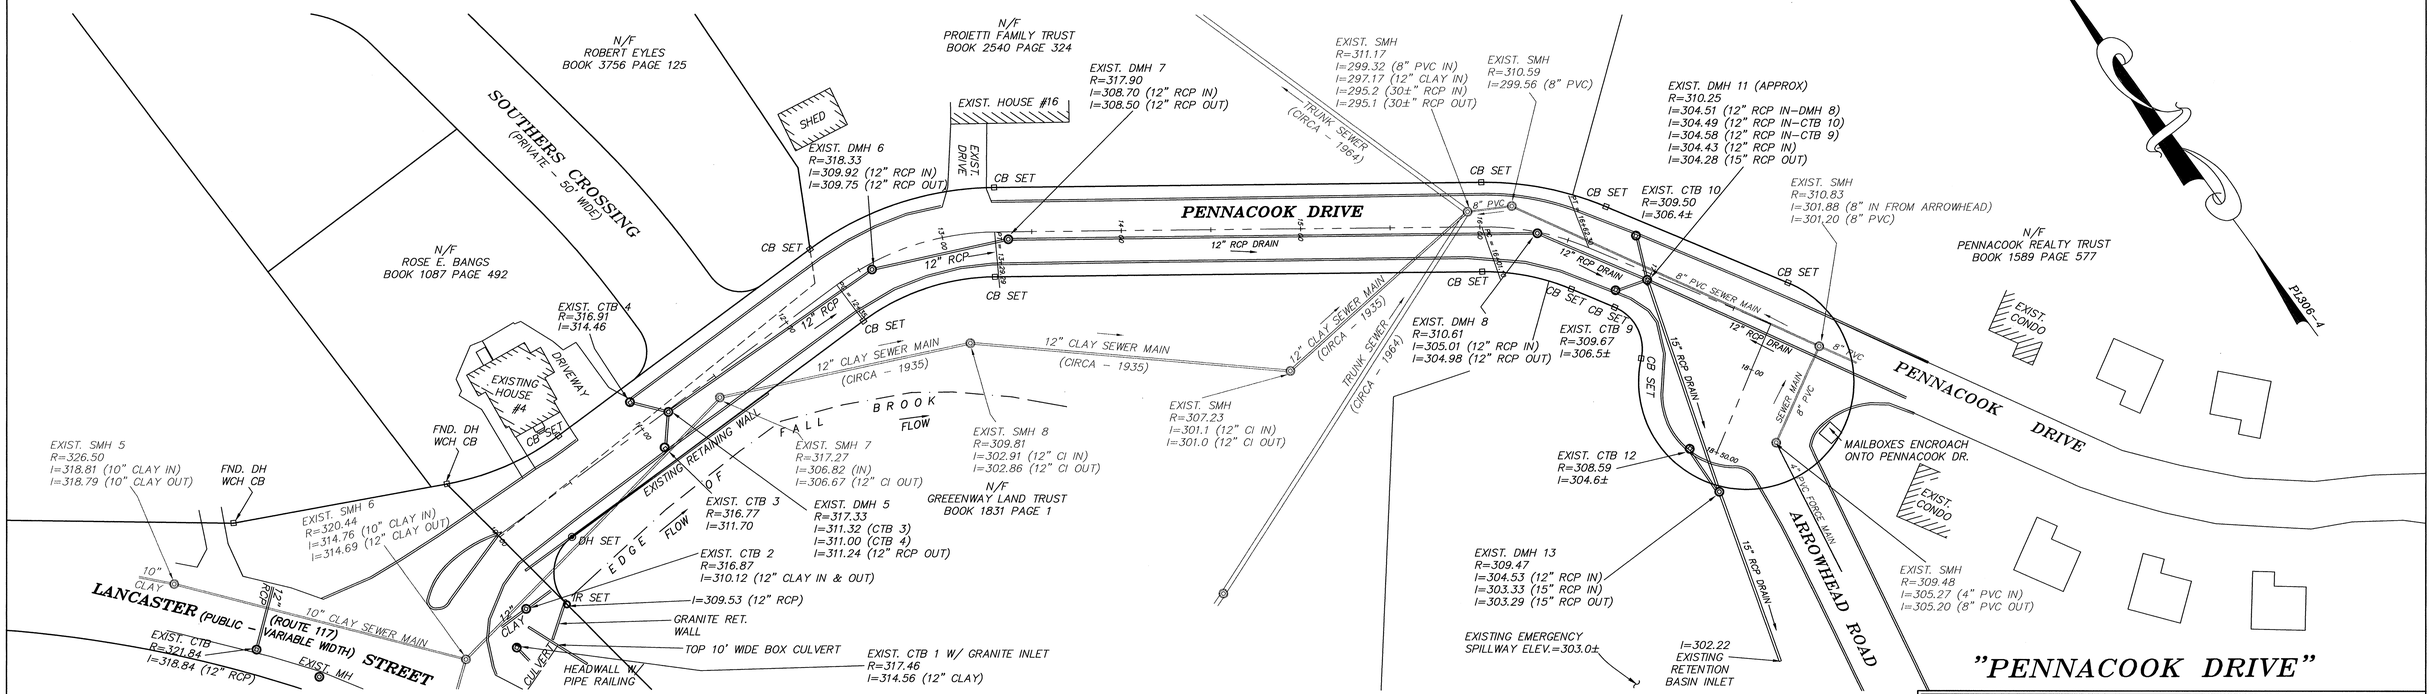

"PENNACOOK DRIVE"

AS-BUILT PLAN & PROFILE
IN
LEOMINSTER, MASSACHUSETTS

PREPARED FOR: PENNACOOK REALTY TRUST 14 MONUMENT SQUARE SUITE 300 LEOMINSTER, MASSACHUSETTS TEL: (978) 534-1121	CALC: PEG CHKD: WDH APPD: WDH	DRWN: PEG SCALE: AS SHOWN DATE: MAR. 6, 2002
DWG: ACCPTNCE SRV: JEF FB: 17-83	HANNIGAN ENGINEERING, INC. CIVIL ENGINEERS & LAND SURVEYORS 8 MONUMENT SQUARE LEOMINSTER, MASSACHUSETTS 01453 (978) 534-1234 FAX (978) 534-6060	JOB NO: 1596 SHEET 1 OF 1 PLAN NO: B-1-21

COMMONWEALTH OF MASSACHUSETTS WILLIAM D. HANNIGAN CIVIL No. 26439 REGISTERED PROFESSIONAL ENGINEER
3-18-02