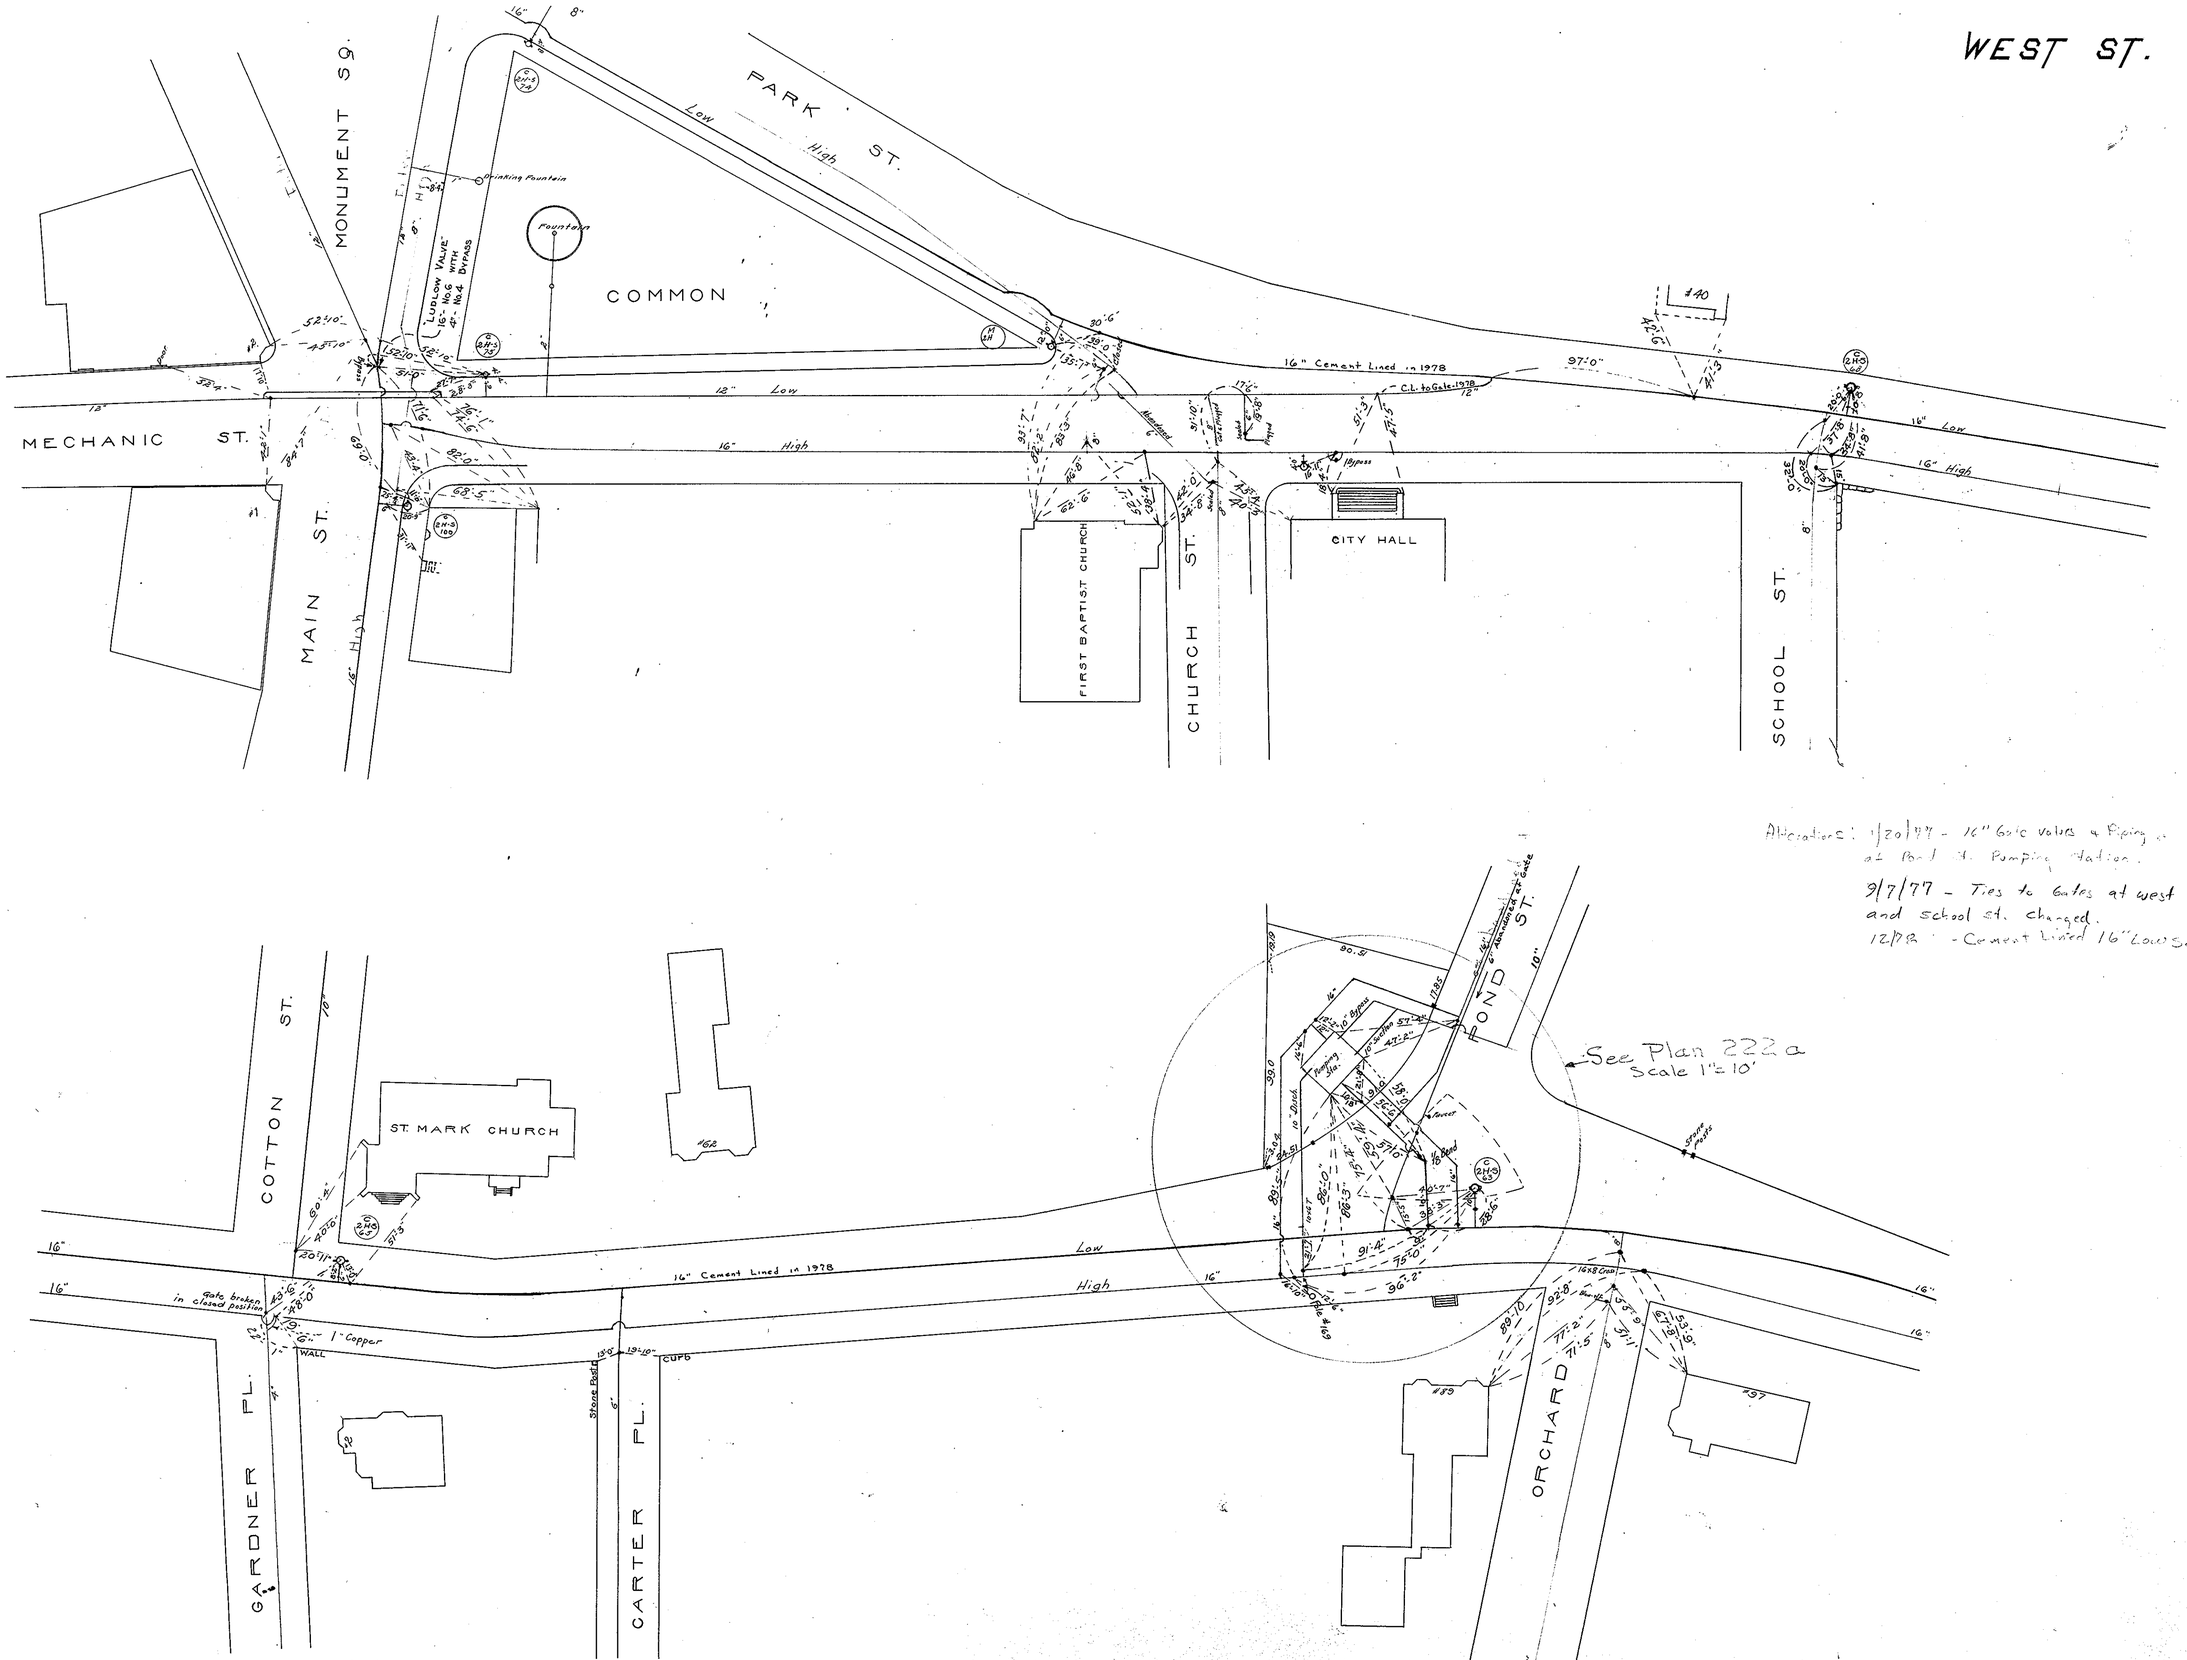
WEST ST.
PARK ST.
MONUMENT SQ.
COMMON
Drinking Fountain
Fountain
LUDLOW VALVE 16"-No.6 WITH 4"-No.4 BYPASS
MECHANIC ST.
MAIN ST.
16" Cement Lined in 1978
C.L. to Gate-1978
12" Low
16" High
16" Low
FIRST BAPTIST CHURCH
CHURCH ST.
CITY HALL
SCHOOL ST.
Alterations: 1/20/77 - 16" Gate Valves & Piping at Park St. Pumping Station.
9/7/77 - Ties to Gates at West and School St. changed.
12/78 - Cement Lined 16" Low Sec.
See Plan 222a Scale 1"=10'
COTTON ST.
ST. MARK CHURCH
FOND ST.
GARDNER PL.
CARTER PL.
ORCHARD
Gate broken in closed position
1" Copper
WALL
CURB
Stone Posts