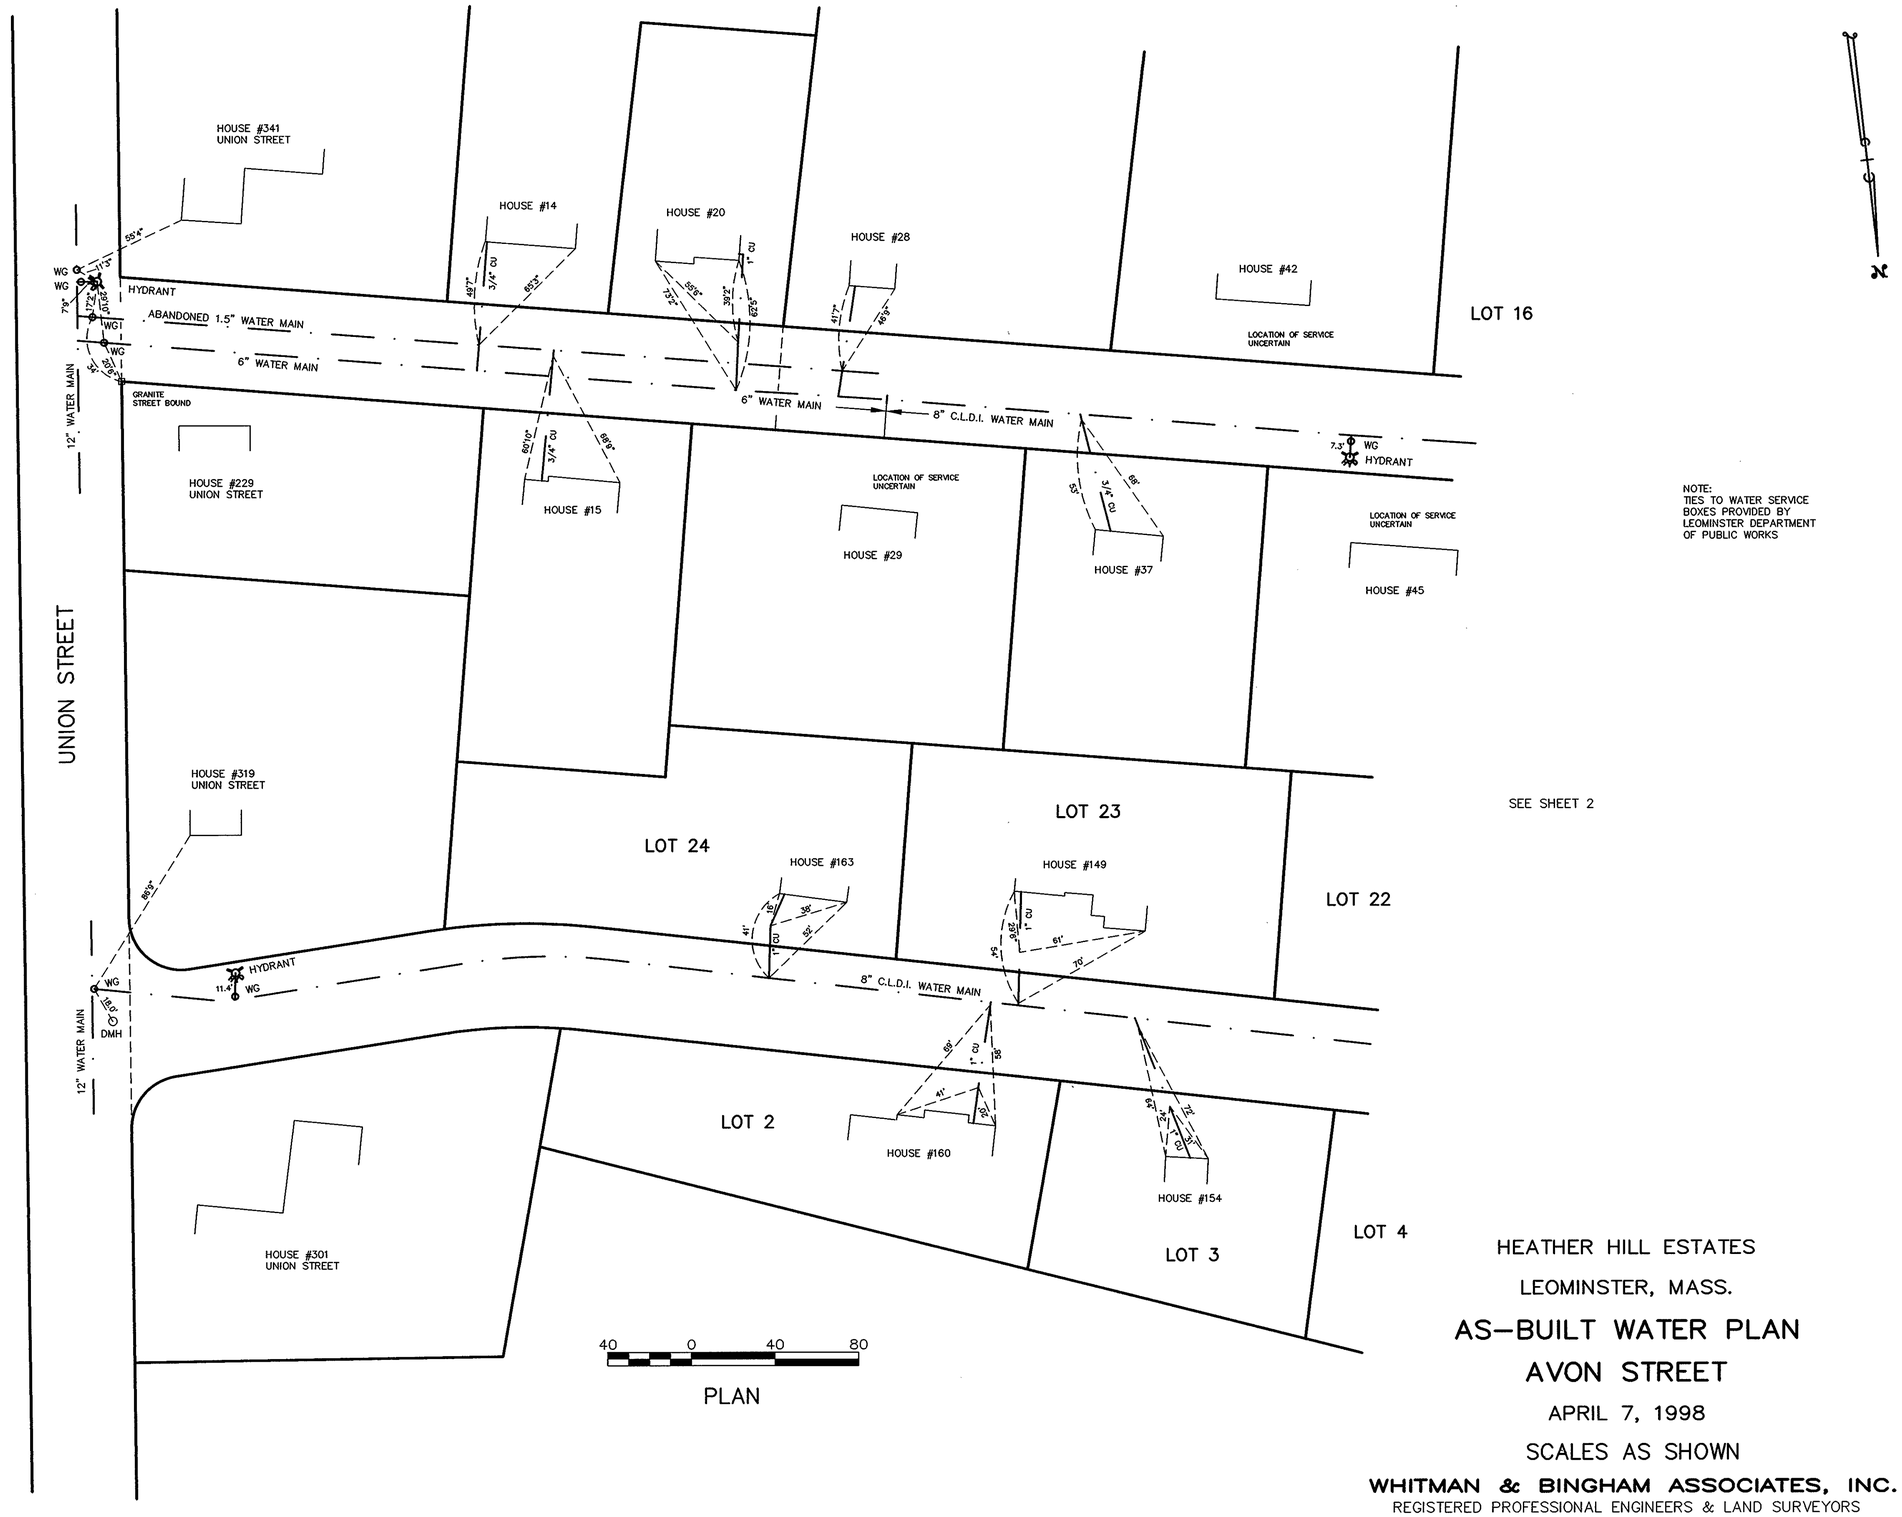

NOTE:
TIES TO WATER SERVICE BOXES PROVIDED BY LEOMINSTER DEPARTMENT OF PUBLIC WORKS

SEE SHEET 2

HEATHER HILL ESTATES

LEOMINSTER, MASS.

AS–BUILT WATER PLAN

AVON STREET

APRIL 7, 1998

SCALES AS SHOWN

WHITMAN & BINGHAM ASSOCIATES, INC.
REGISTERED PROFESSIONAL ENGINEERS & LAND SURVEYORS
510 MECHANIC STREET – LEOMINSTER, MASSACHUSETTS 01453