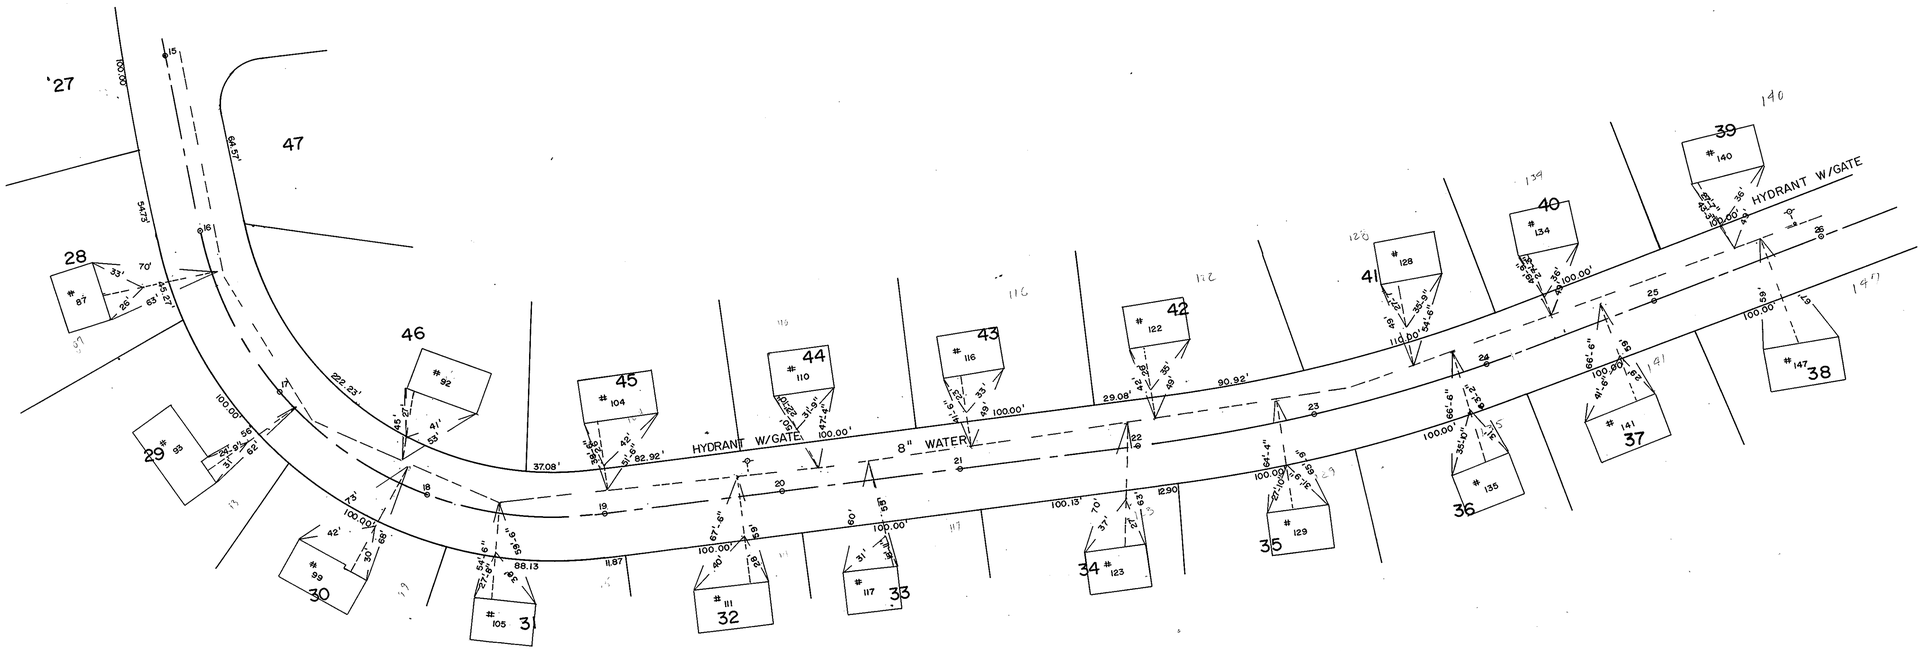

40 0 40 80

PLAN

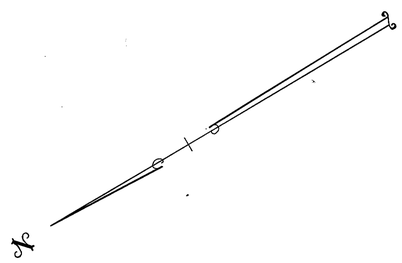

AS BUILT
WATER PLAN
OF
BIRCHCROFT ROAD
IN LEOMINSTER, MASS.
NOVEMBER 24, 1987

642 A