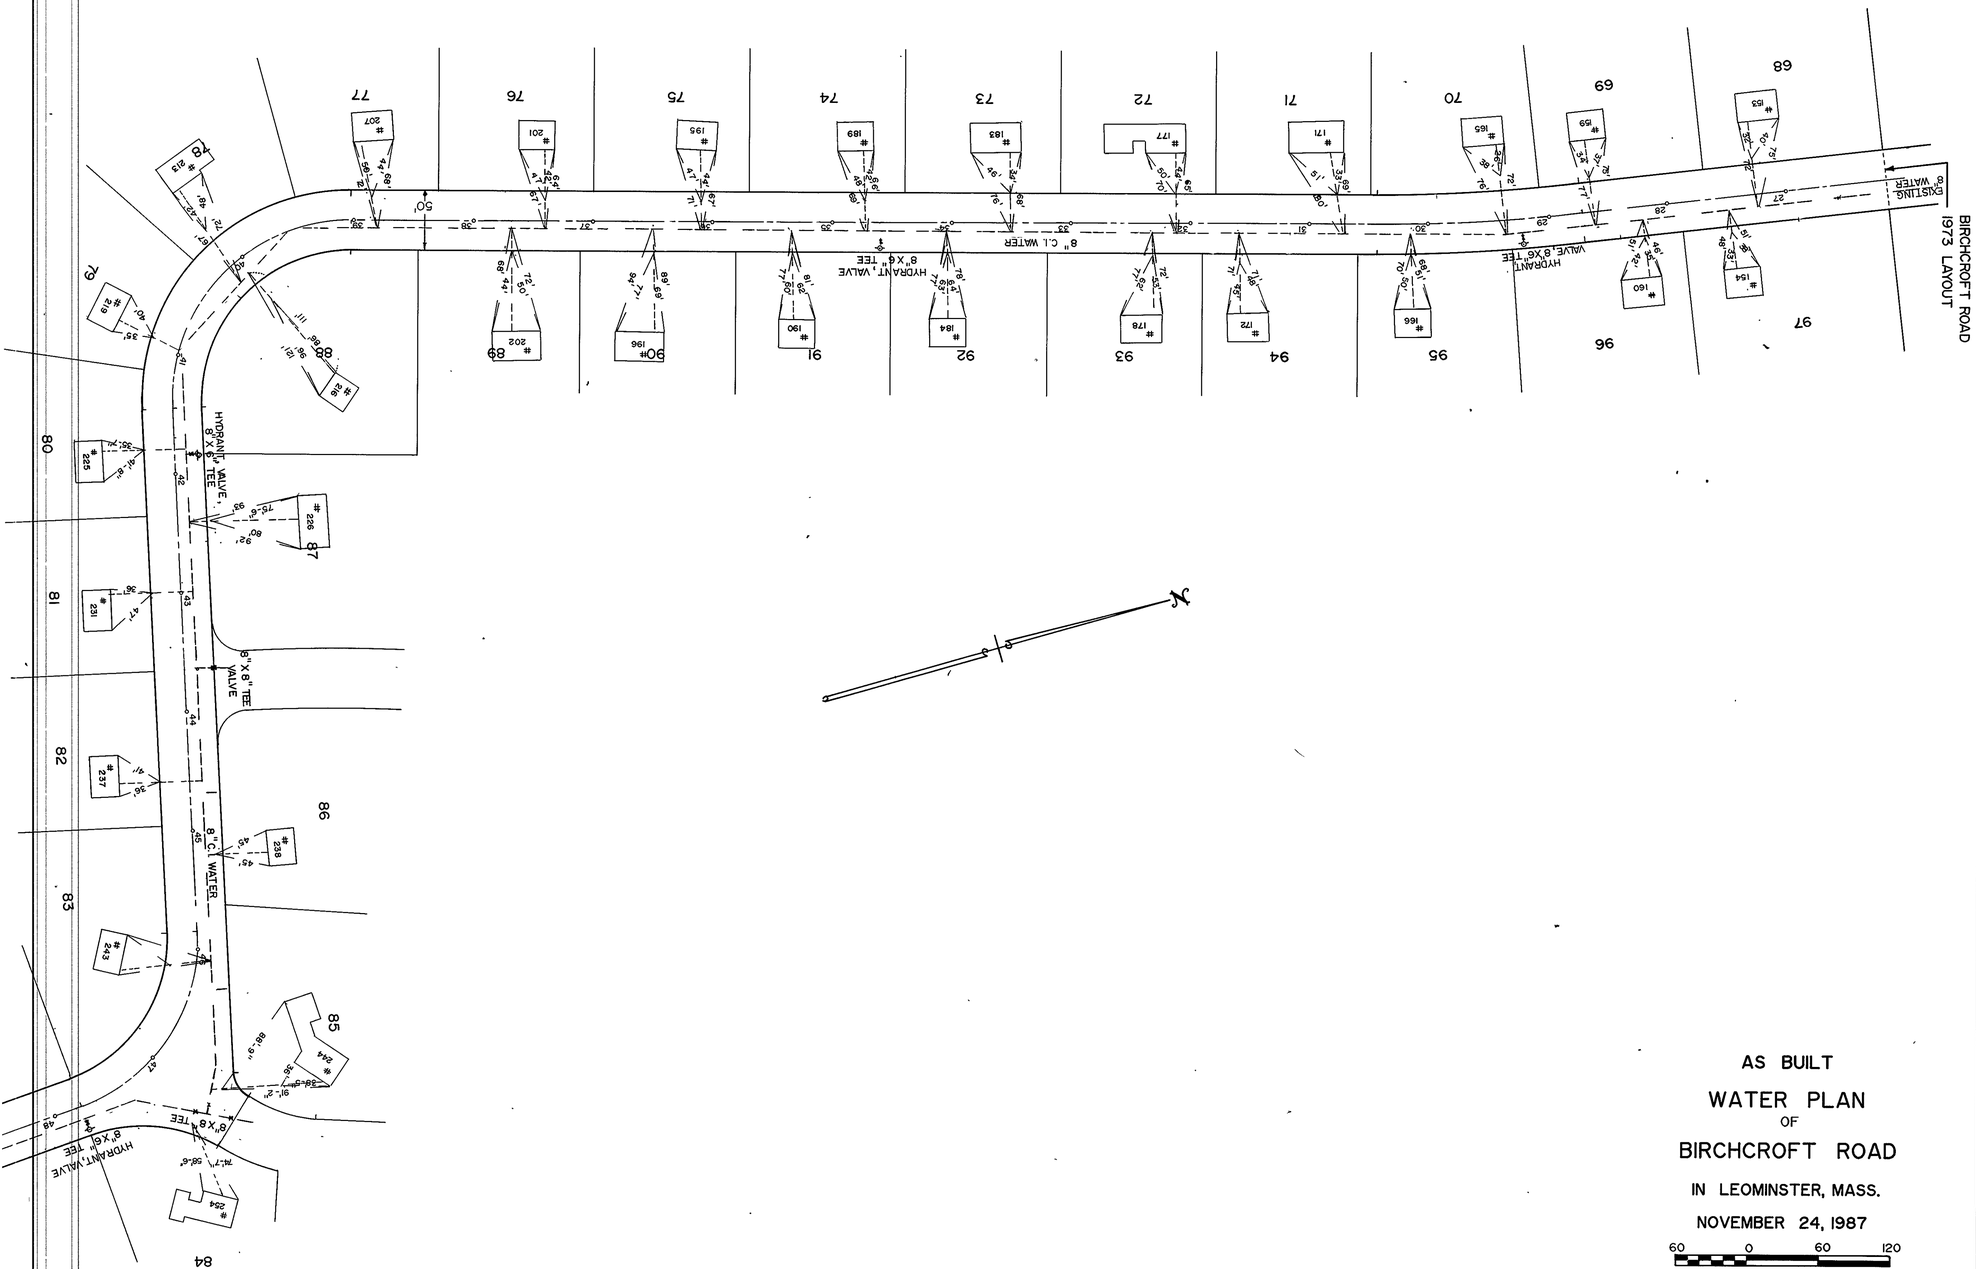

AS BUILT

WATER PLAN

OF

BIRCHCROFT ROAD

IN LEOMINSTER, MASS.

NOVEMBER 24, 1987

60 0 60 120

642 B