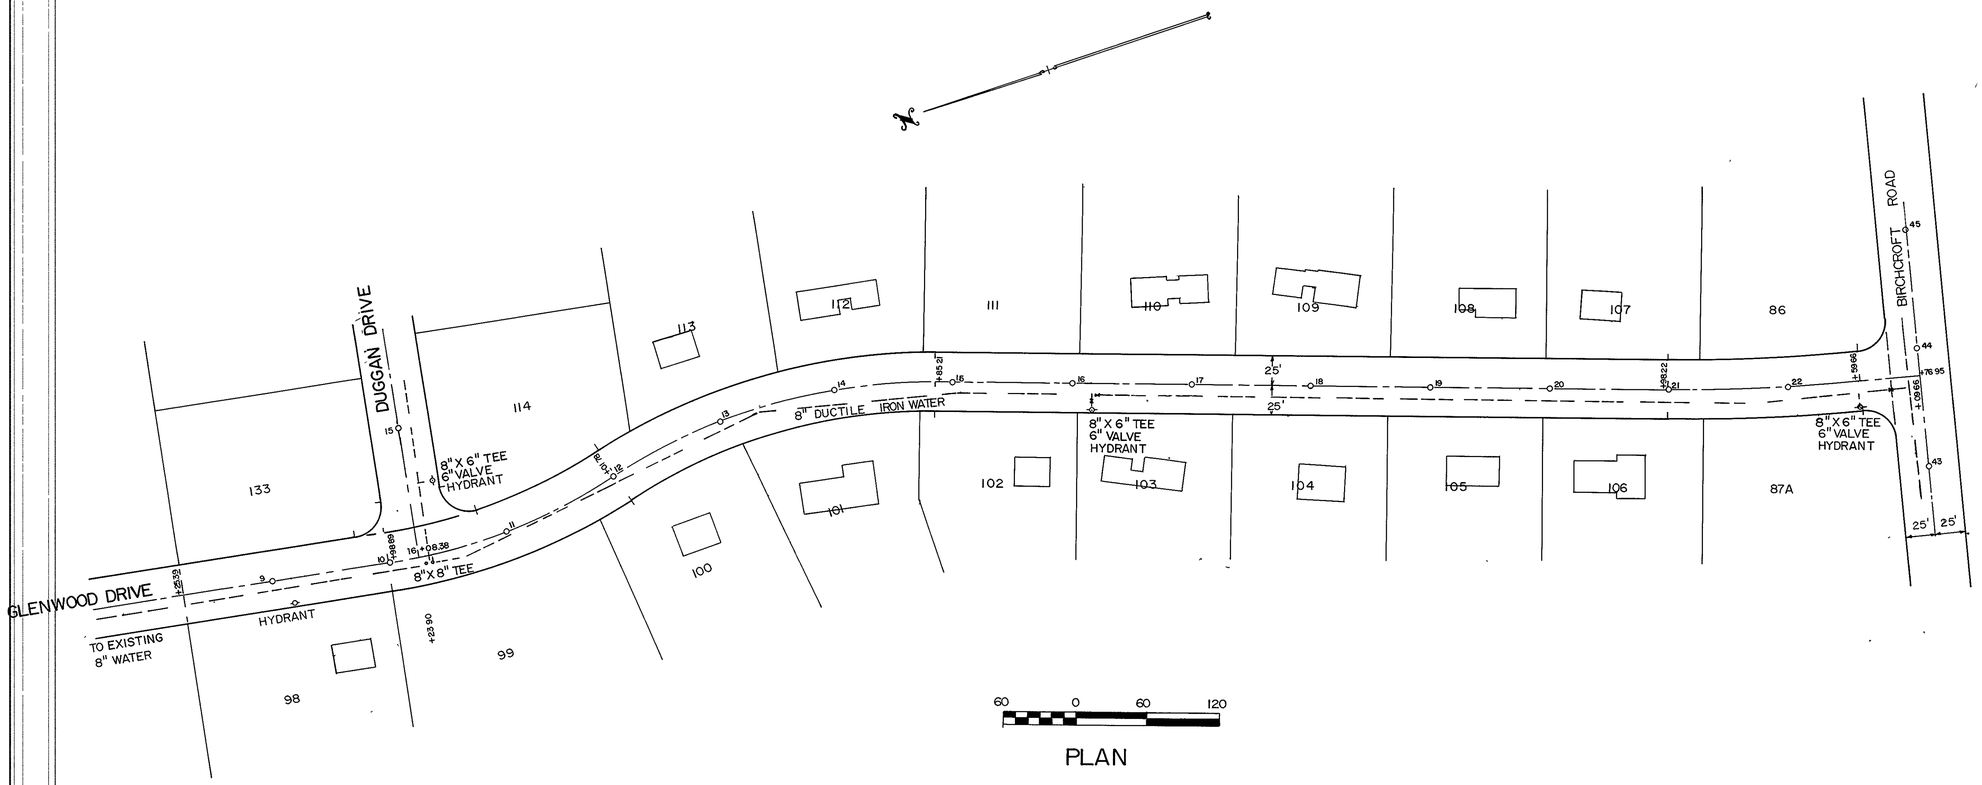

PLAN

AS BUILT

WATER PLAN

OF

GLENWOOD DRIVE EXTENSION

IN LEOMINSTER, MASS.

DECEMBER 2, 1987