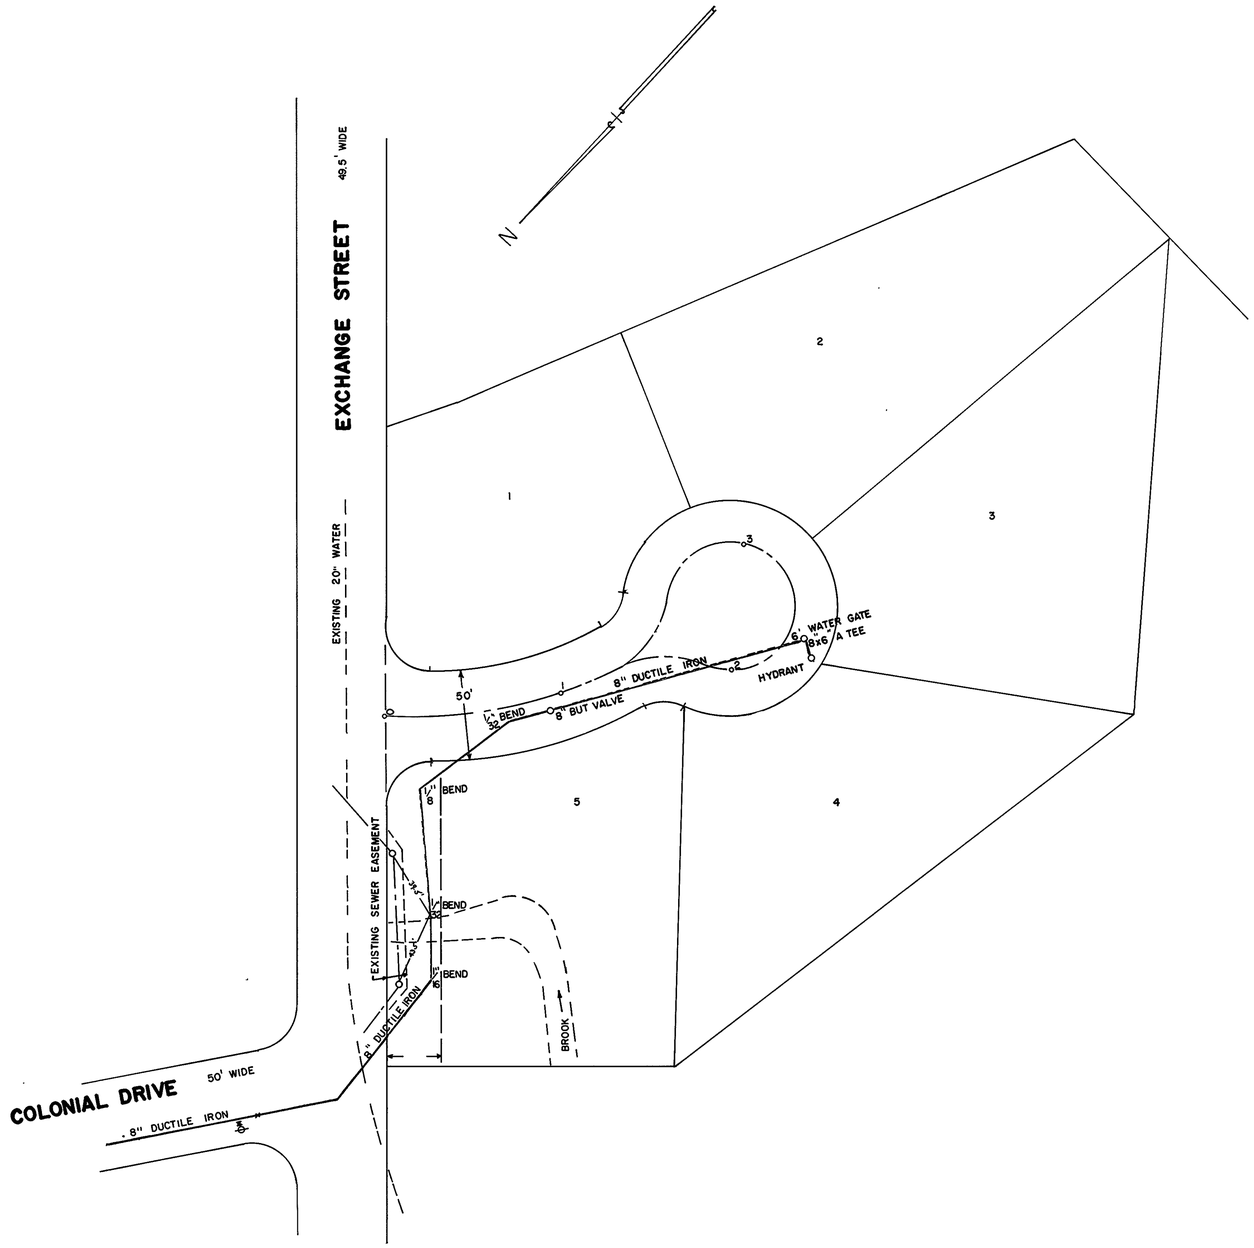

AS BUILT

WATER PLAN

OF

MAYFLOWER CIRCLE

IN LEOMINSTER, MASS.

DECEMBER 2, 1986

40 0 40 80