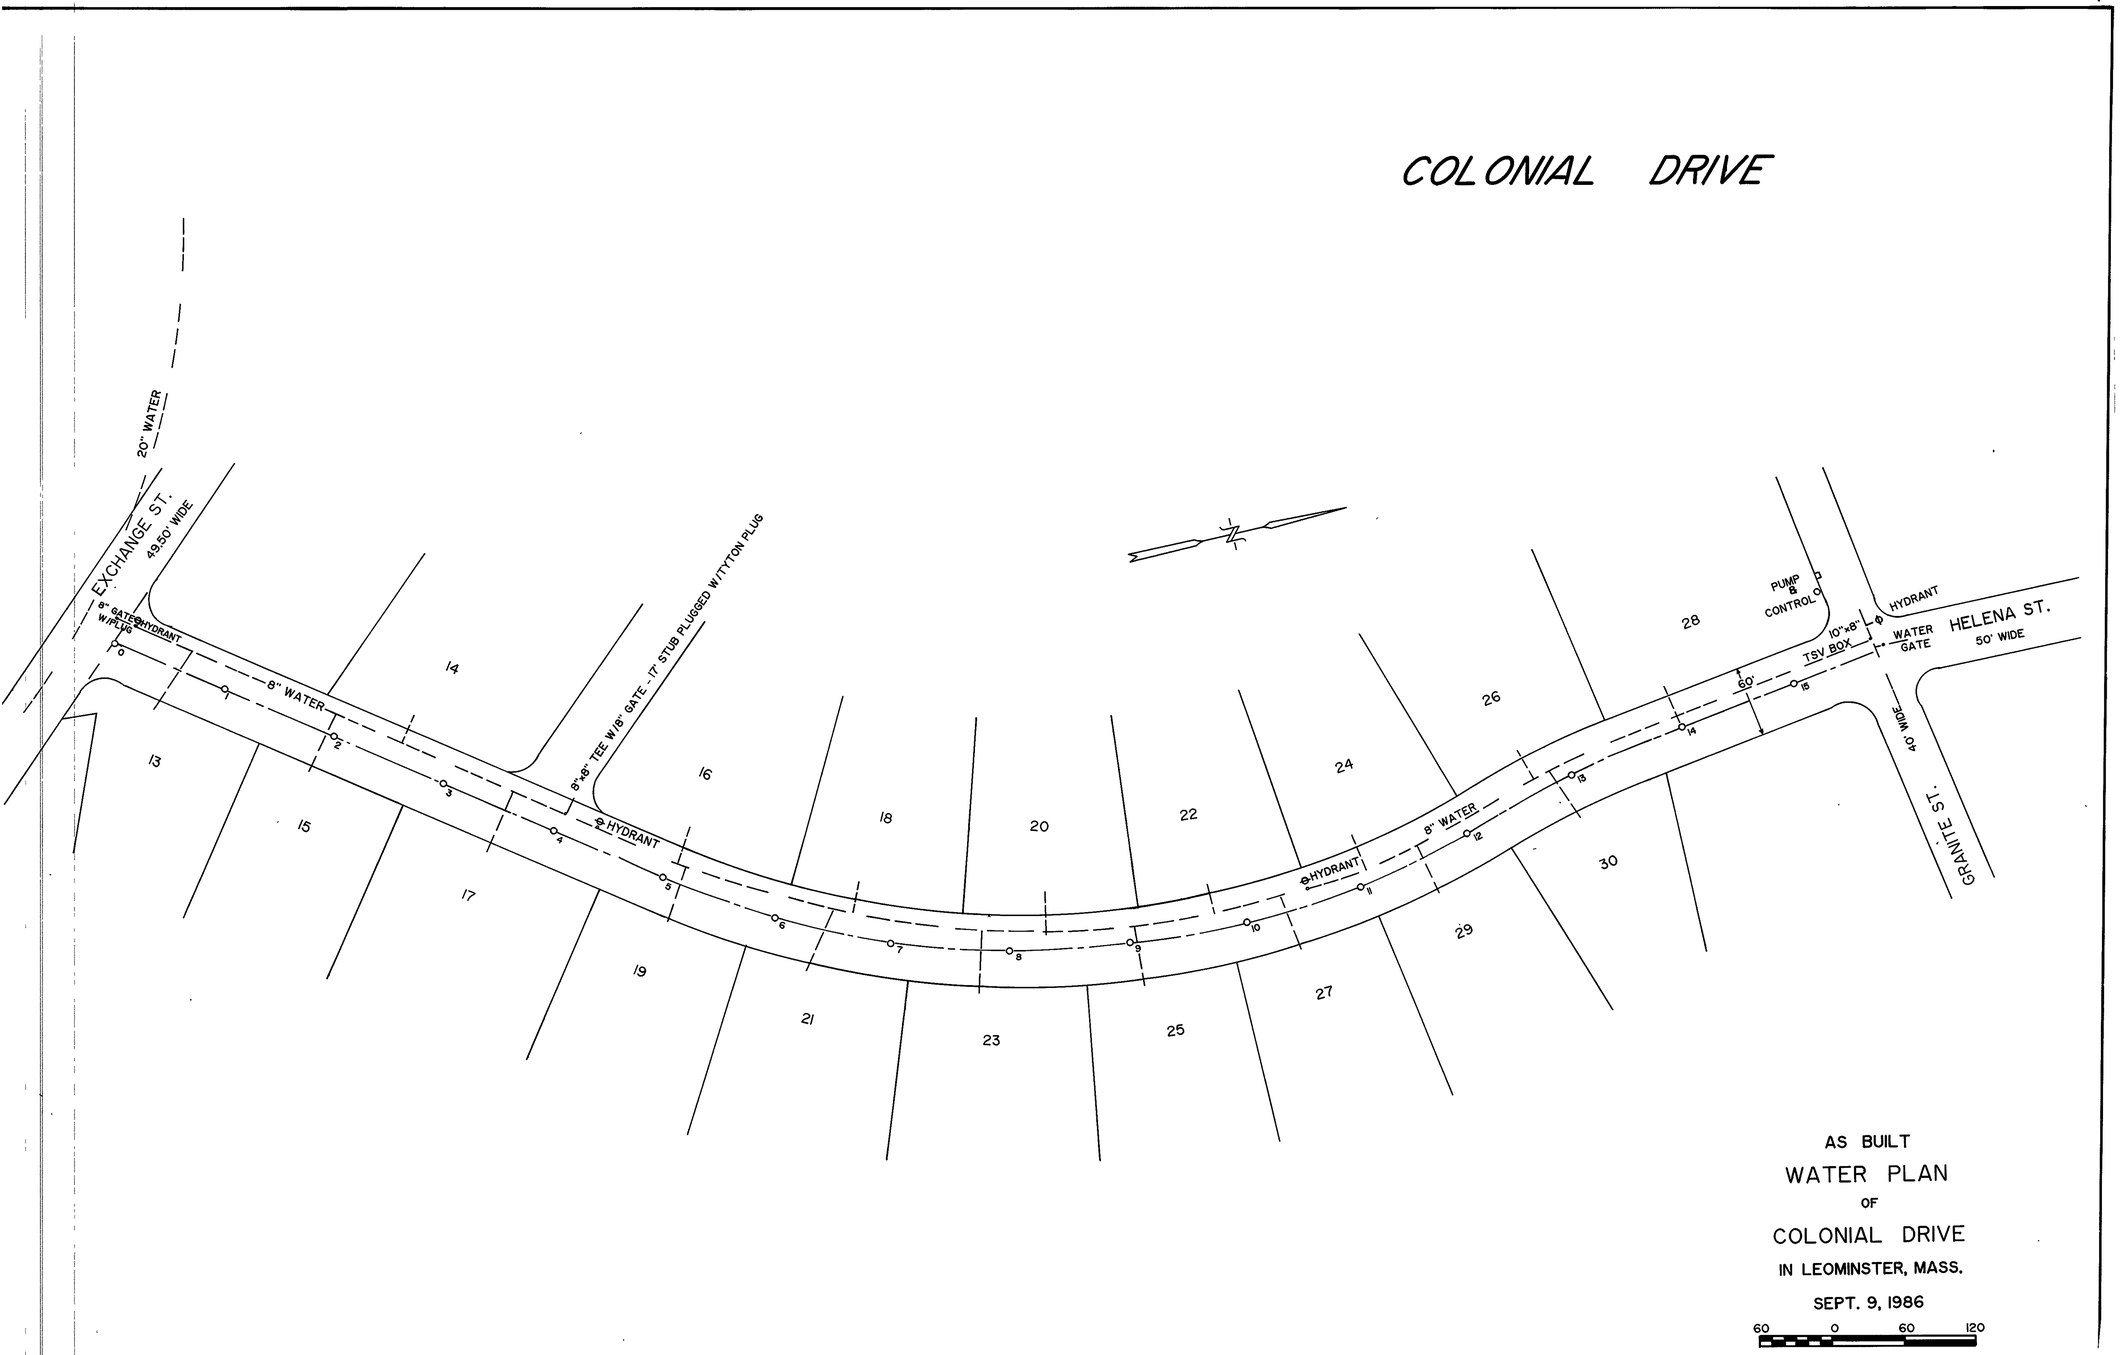
COLONIAL DRIVE
EXCHANGE ST.
49.50' WIDE
20" WATER
8" GATE & HYDRANT W/PLUG
8" WATER
9"x8" TEE W/8" GATE - 17' STUB PLUGGED W/TYTON PLUG
HYDRANT
HYDRANT
8" WATER
HYDRANT
PUMP & CONTROL
HYDRANT
10"x8"
TSV BOX
WATER GATE
HELENA ST.
50' WIDE
60'
40' WIDE
GRANITE ST.
13
14
15
16
17
18
19
20
21
22
23
24
25
26
27
28
29
30
AS BUILT
WATER PLAN
OF
COLONIAL DRIVE
IN LEOMINSTER, MASS.
SEPT. 9, 1986
60 0 60 120