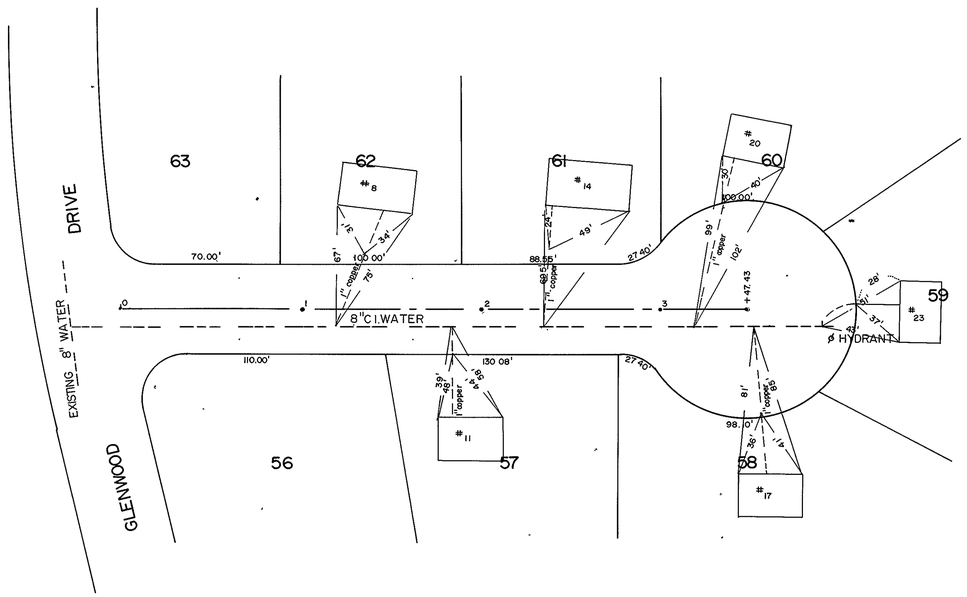

AS BUILT

WATER PLAN

OF

SHADY LANE

IN LEOMINSTER, MASS.

NOVEMBER 24, 1987

40 0 40 80

WILLIAM R. BINGHAM & ASSOC. ENGRS. & SURVEYORS

24 COLUMBIA ST. — LEOMINSTER, MASS