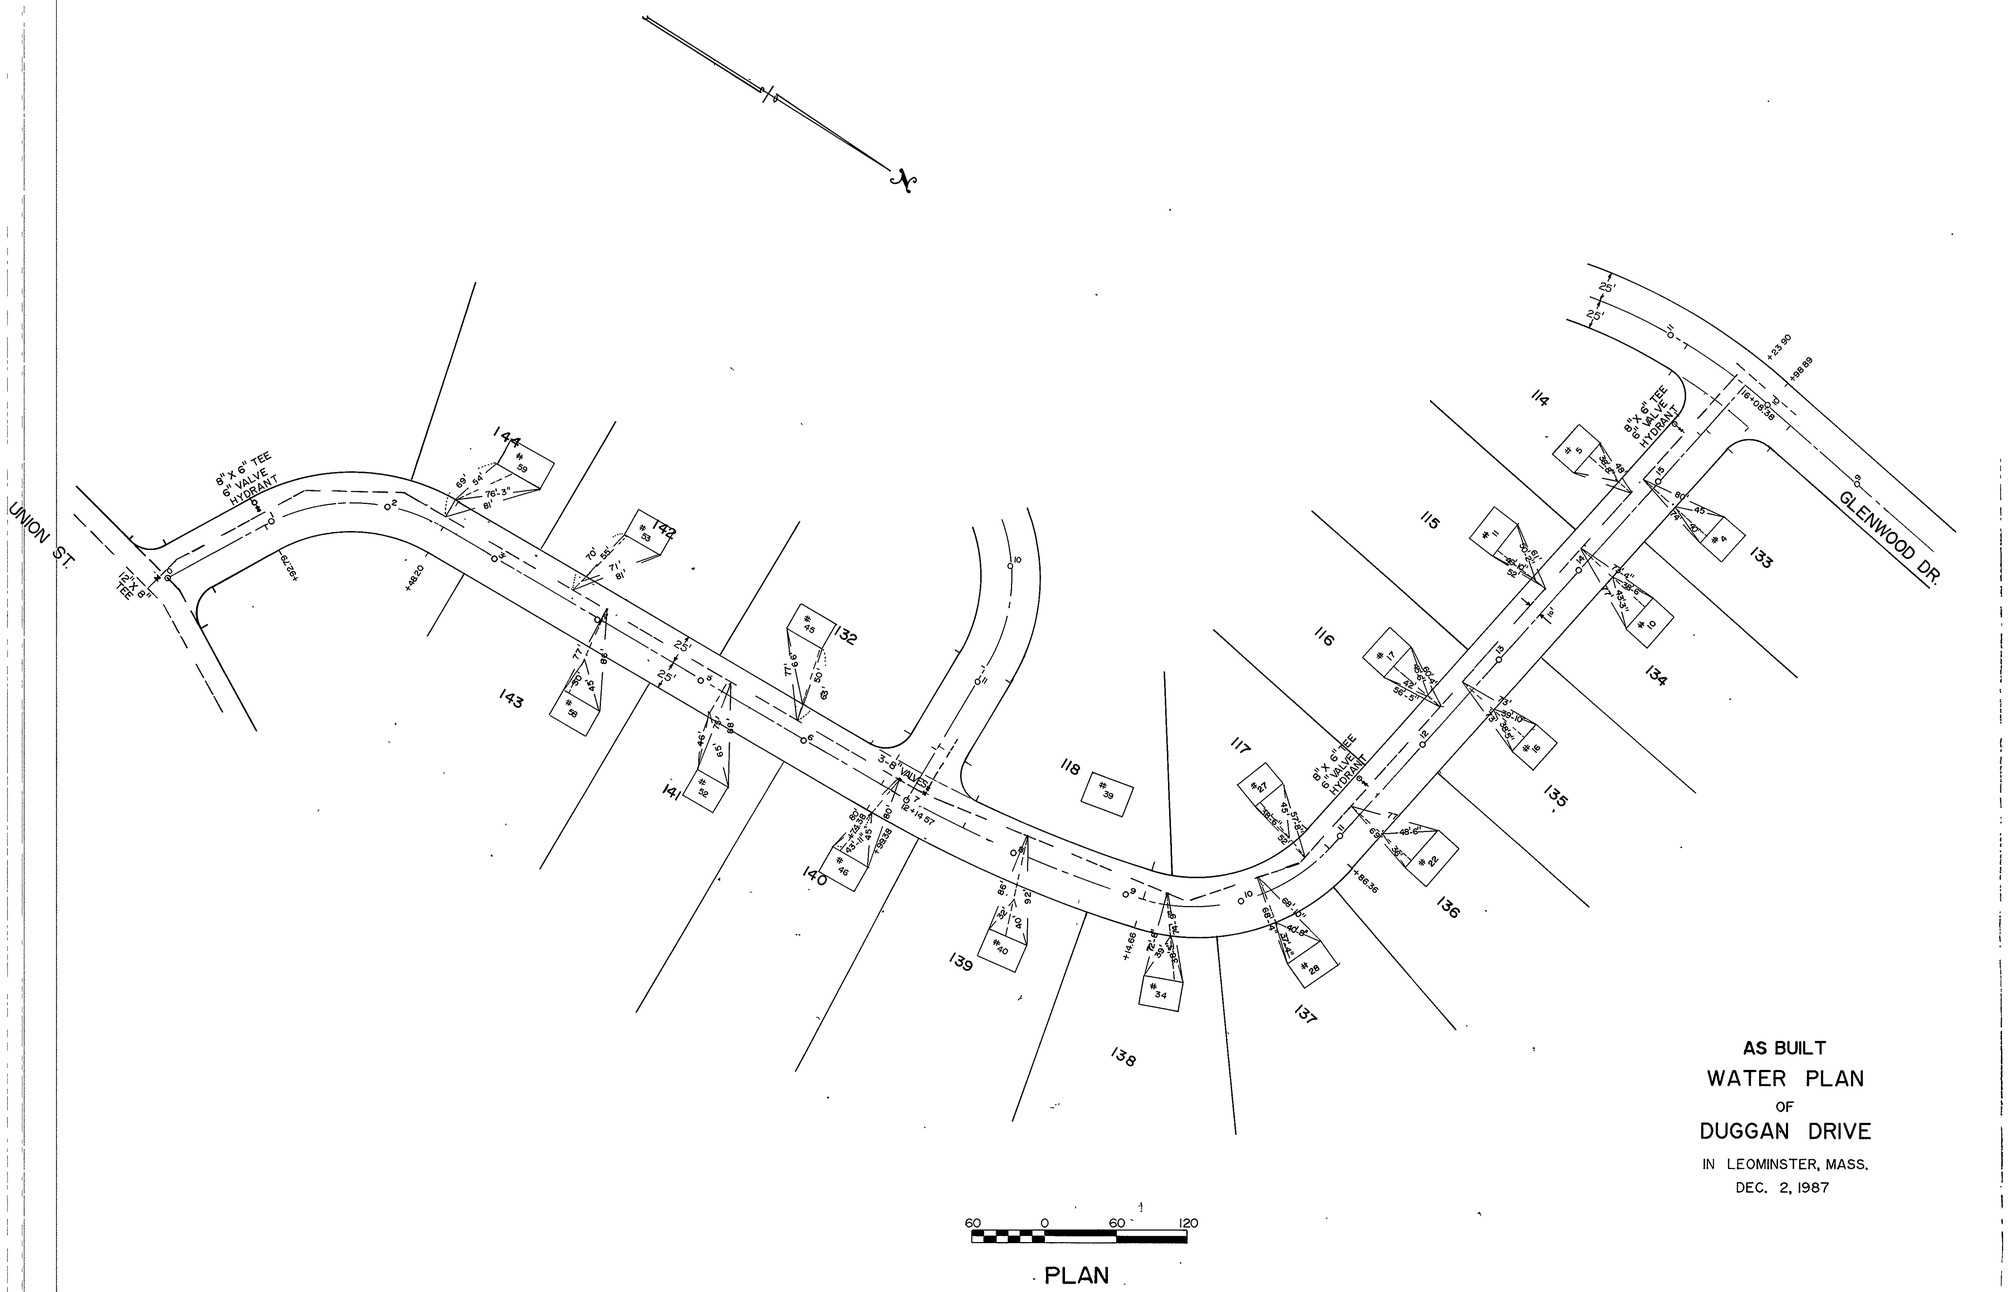

AS BUILT
WATER PLAN
OF
DUGGAN DRIVE
IN LEOMINSTER, MASS.
DEC. 2, 1987