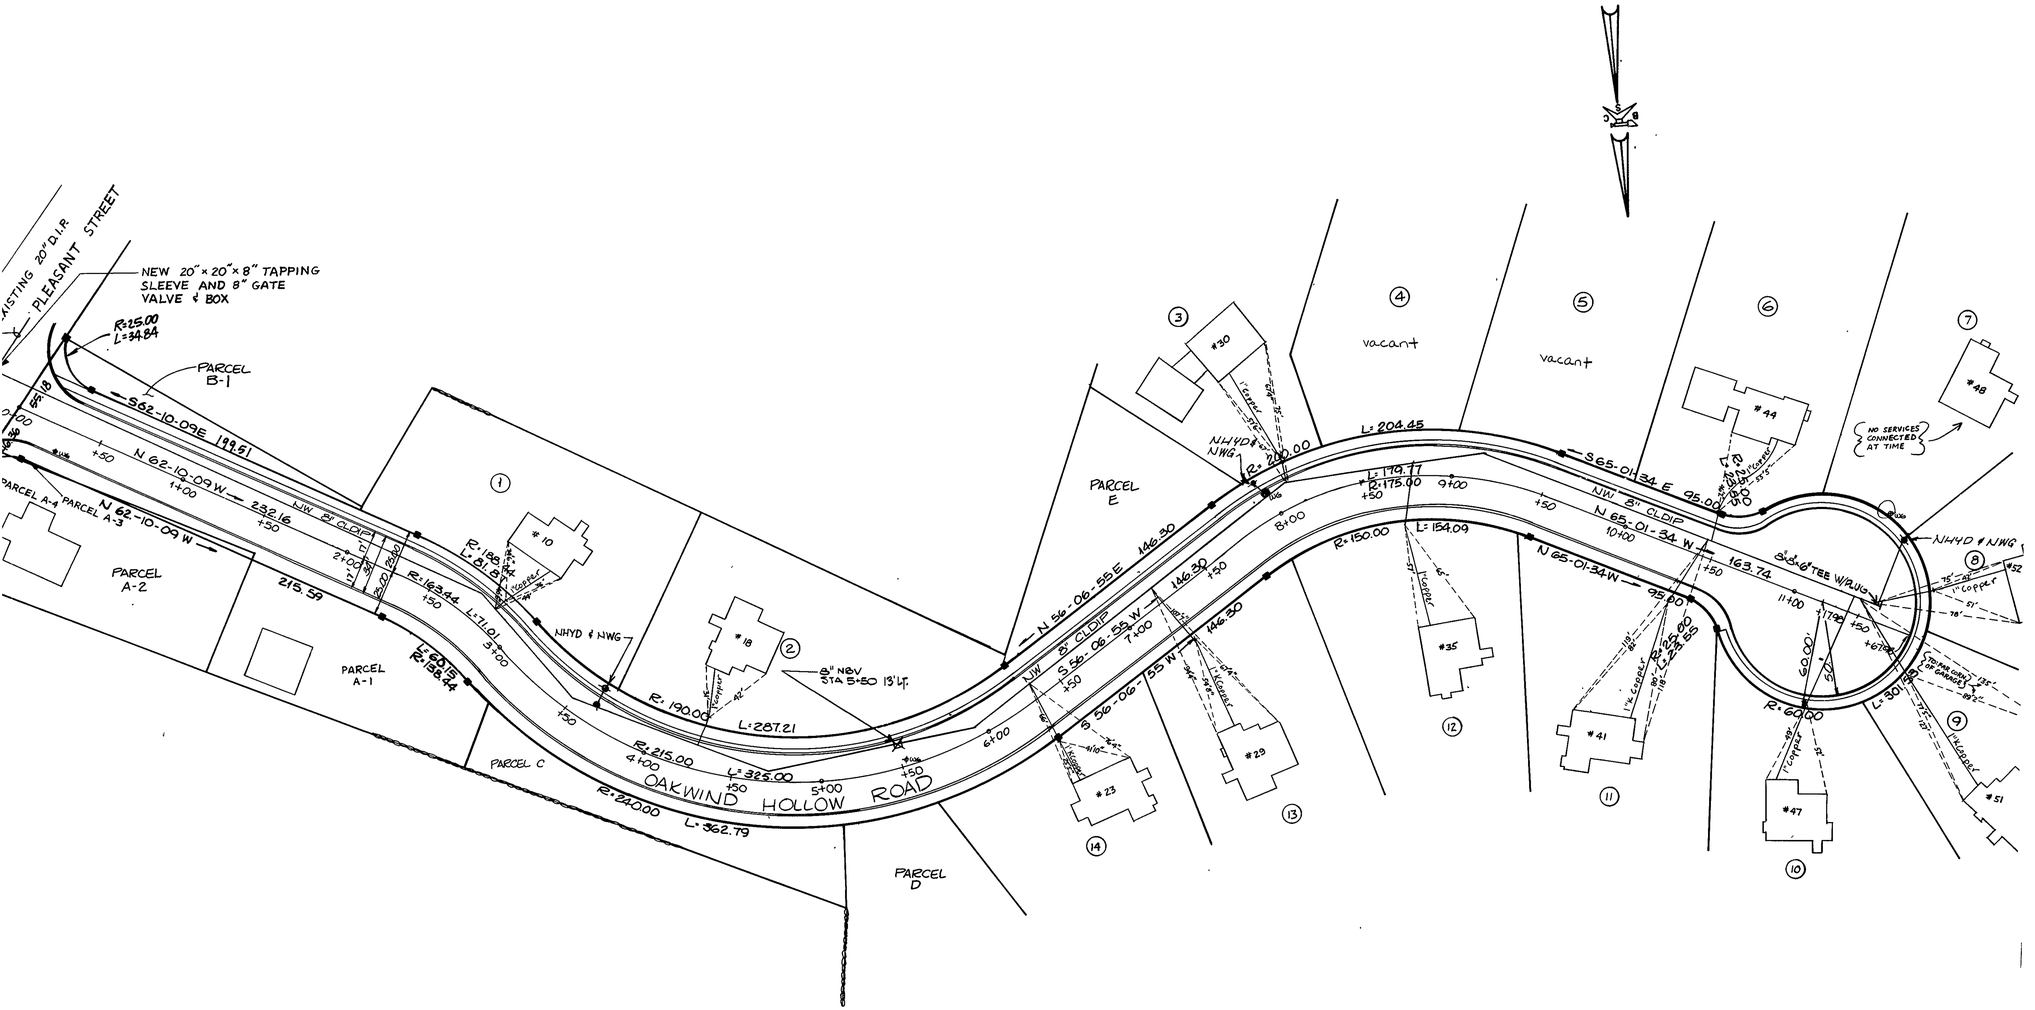

0 40 80 160

PLAN
1" = 40'

COMMONWEALTH OF MASSACHUSETTS
ADRIAN O'HARA-DUMAS
No 33942
PROFESSIONAL LAND SURVEYOR

Adrian O'Hara-Dumas

"AS BUILT"
WATER PLAN
OF
OAKWIND HOLLOW ROAD
IN LEOMINSTER, MASS.
FEBRUARY 1, 1989

THE BSC GROUP - WORCESTER, INC.