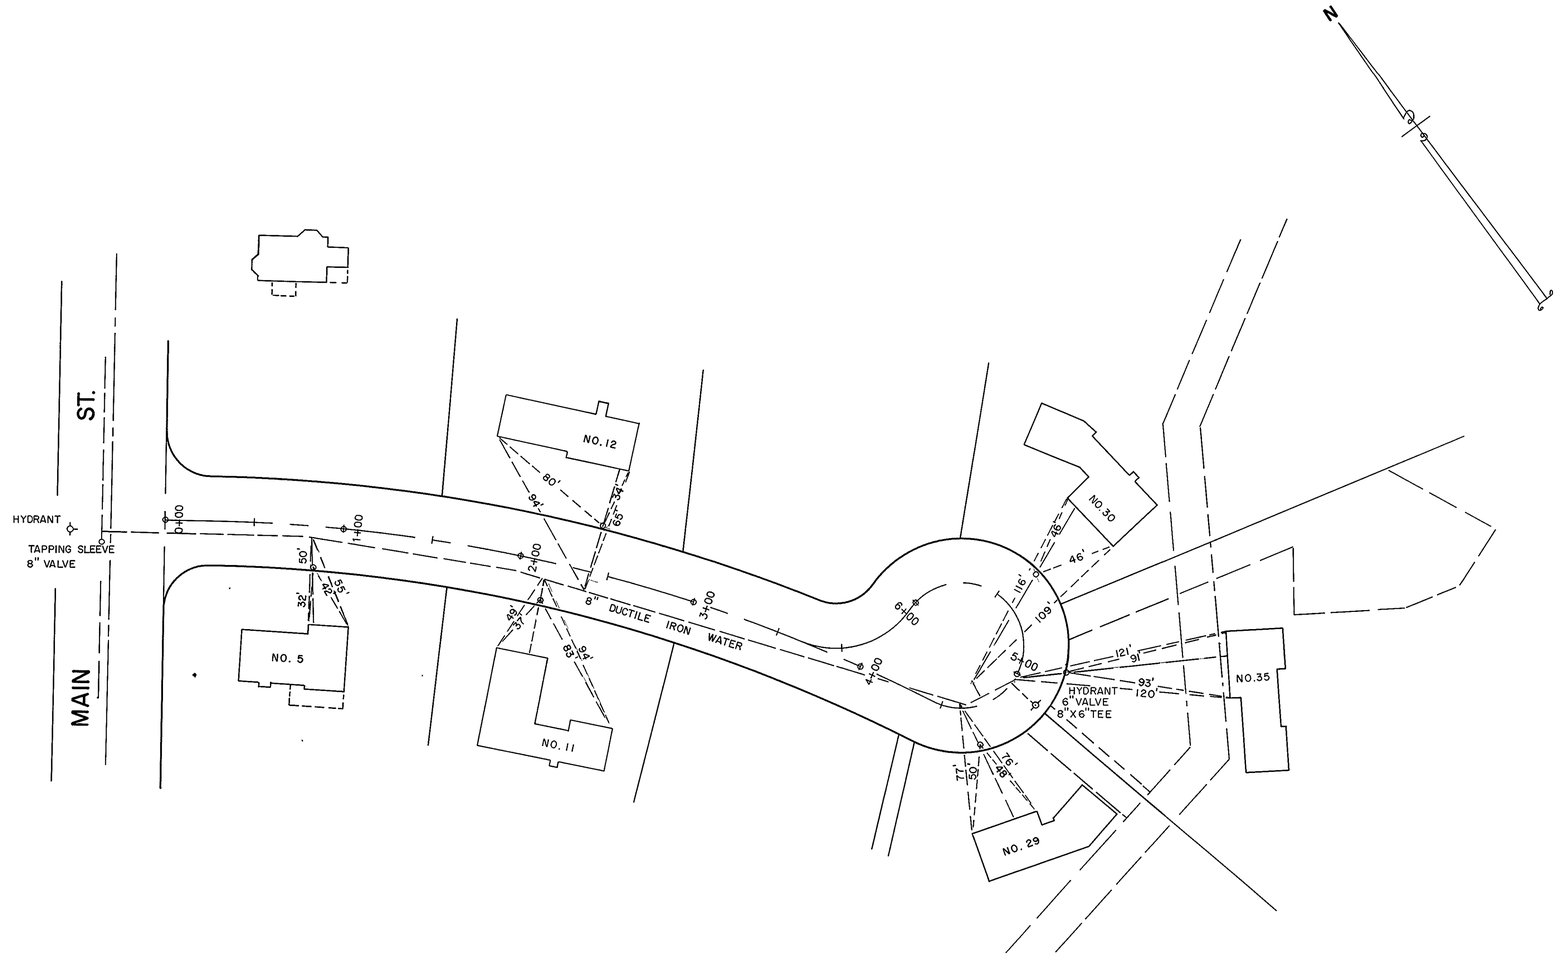

AS BUILT

WATER PLAN

OF

NORTH MEADOW ROAD

JUNE 5, 1990

40 0 40 80

WHITMAN & BINGHAM ASSOC. – REG. ENGINEERS & SURVEYORS
305 WHITNEY STREET – LEOMINSTER, MASS. 01453

PLAN 21–D–6