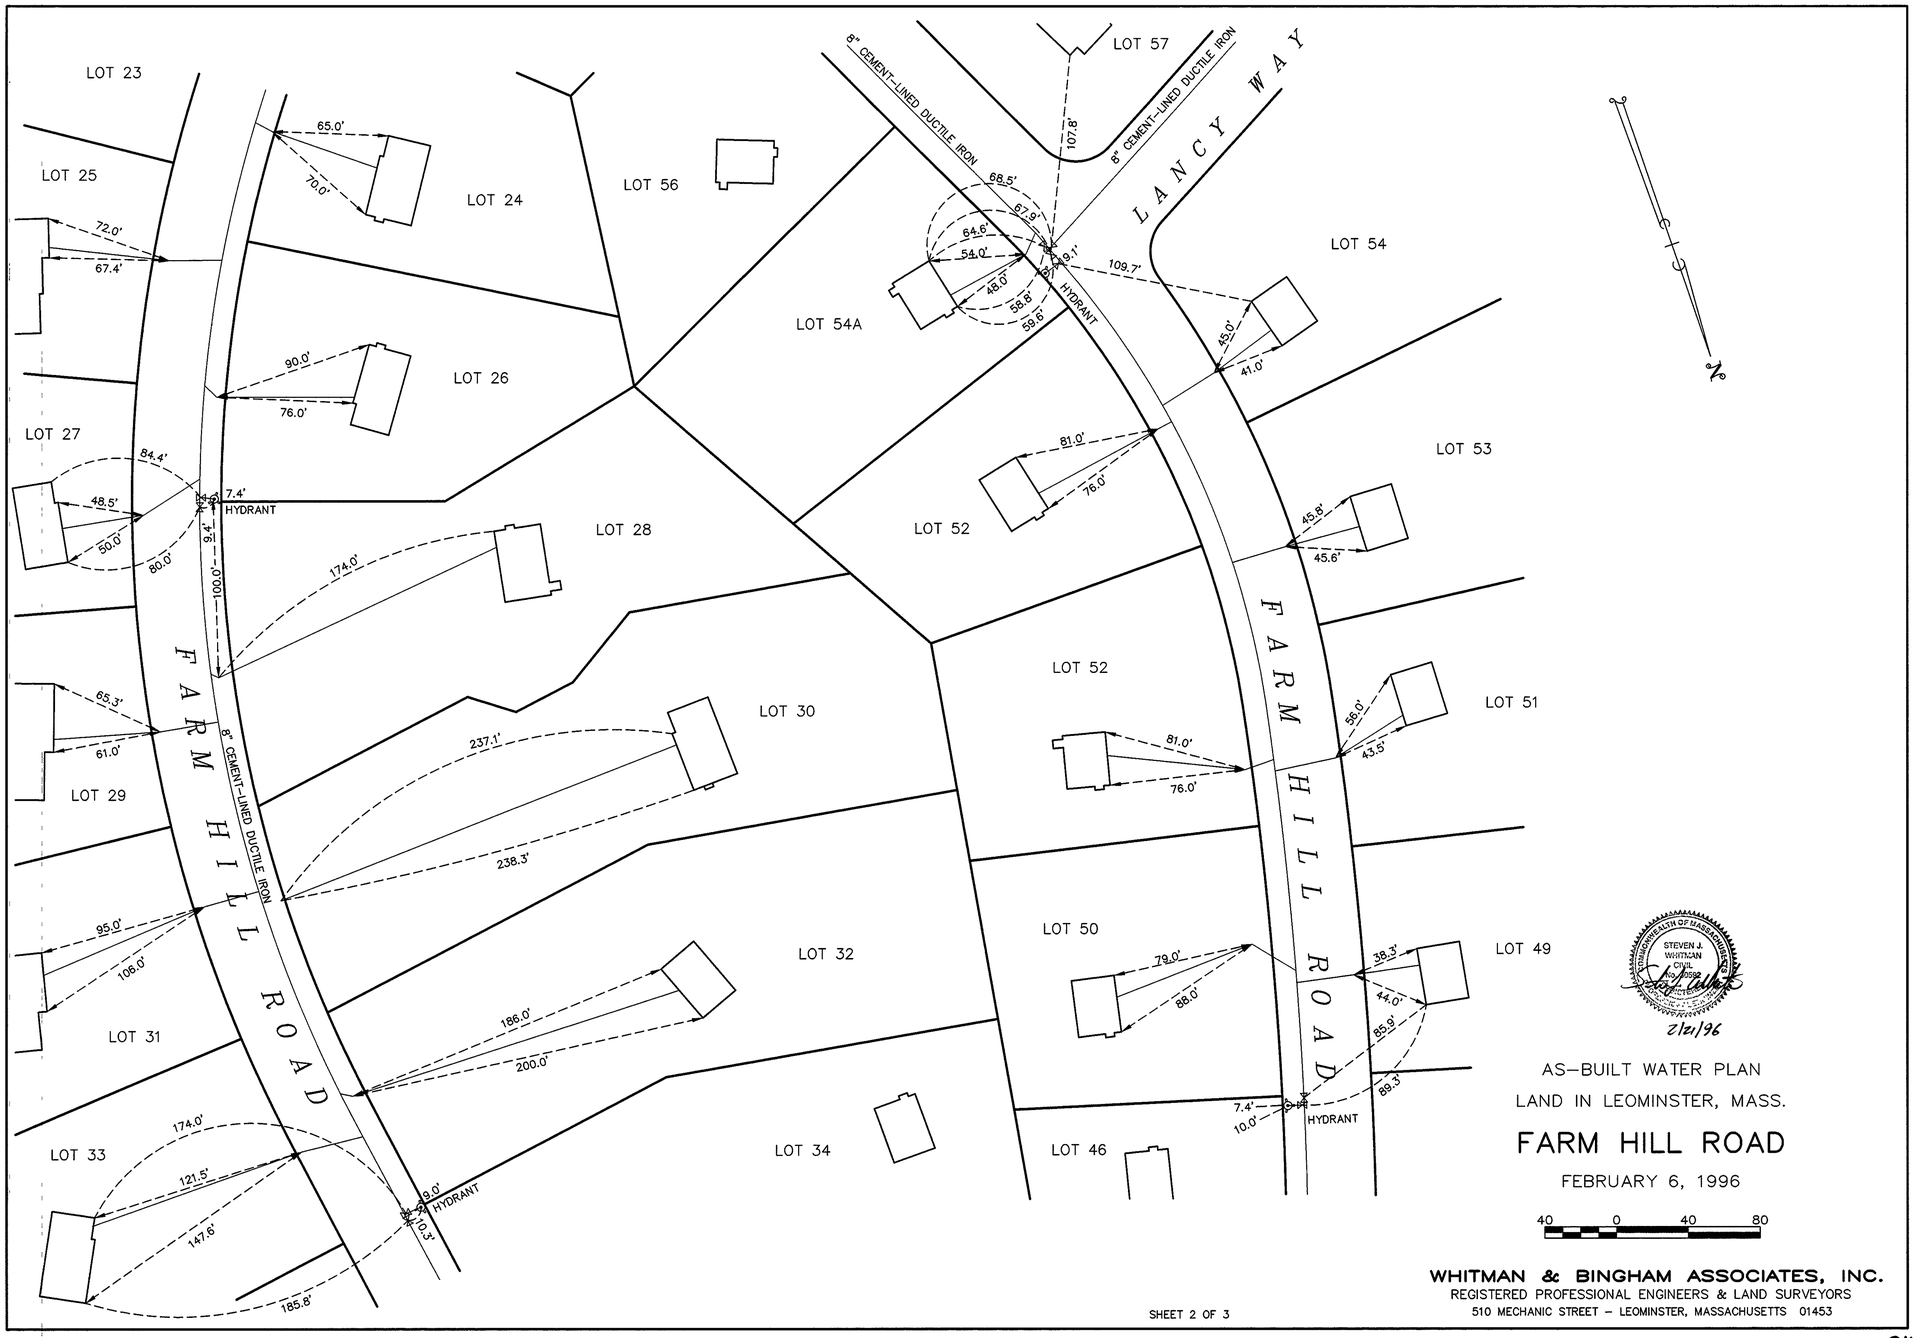

COMMONWEALTH OF MASSACHUSETTS
STEVEN J. WHITMAN
CIVIL
No. 17092
REGISTERED PROFESSIONAL ENGINEER

2/21/96

AS-BUILT WATER PLAN

LAND IN LEOMINSTER, MASS.

FARM HILL ROAD

FEBRUARY 6, 1996

40 0 40 80

WHITMAN & BINGHAM ASSOCIATES, INC.
REGISTERED PROFESSIONAL ENGINEERS & LAND SURVEYORS
510 MECHANIC STREET – LEOMINSTER, MASSACHUSETTS 01453

SHEET 2 OF 3

21-D-7 843