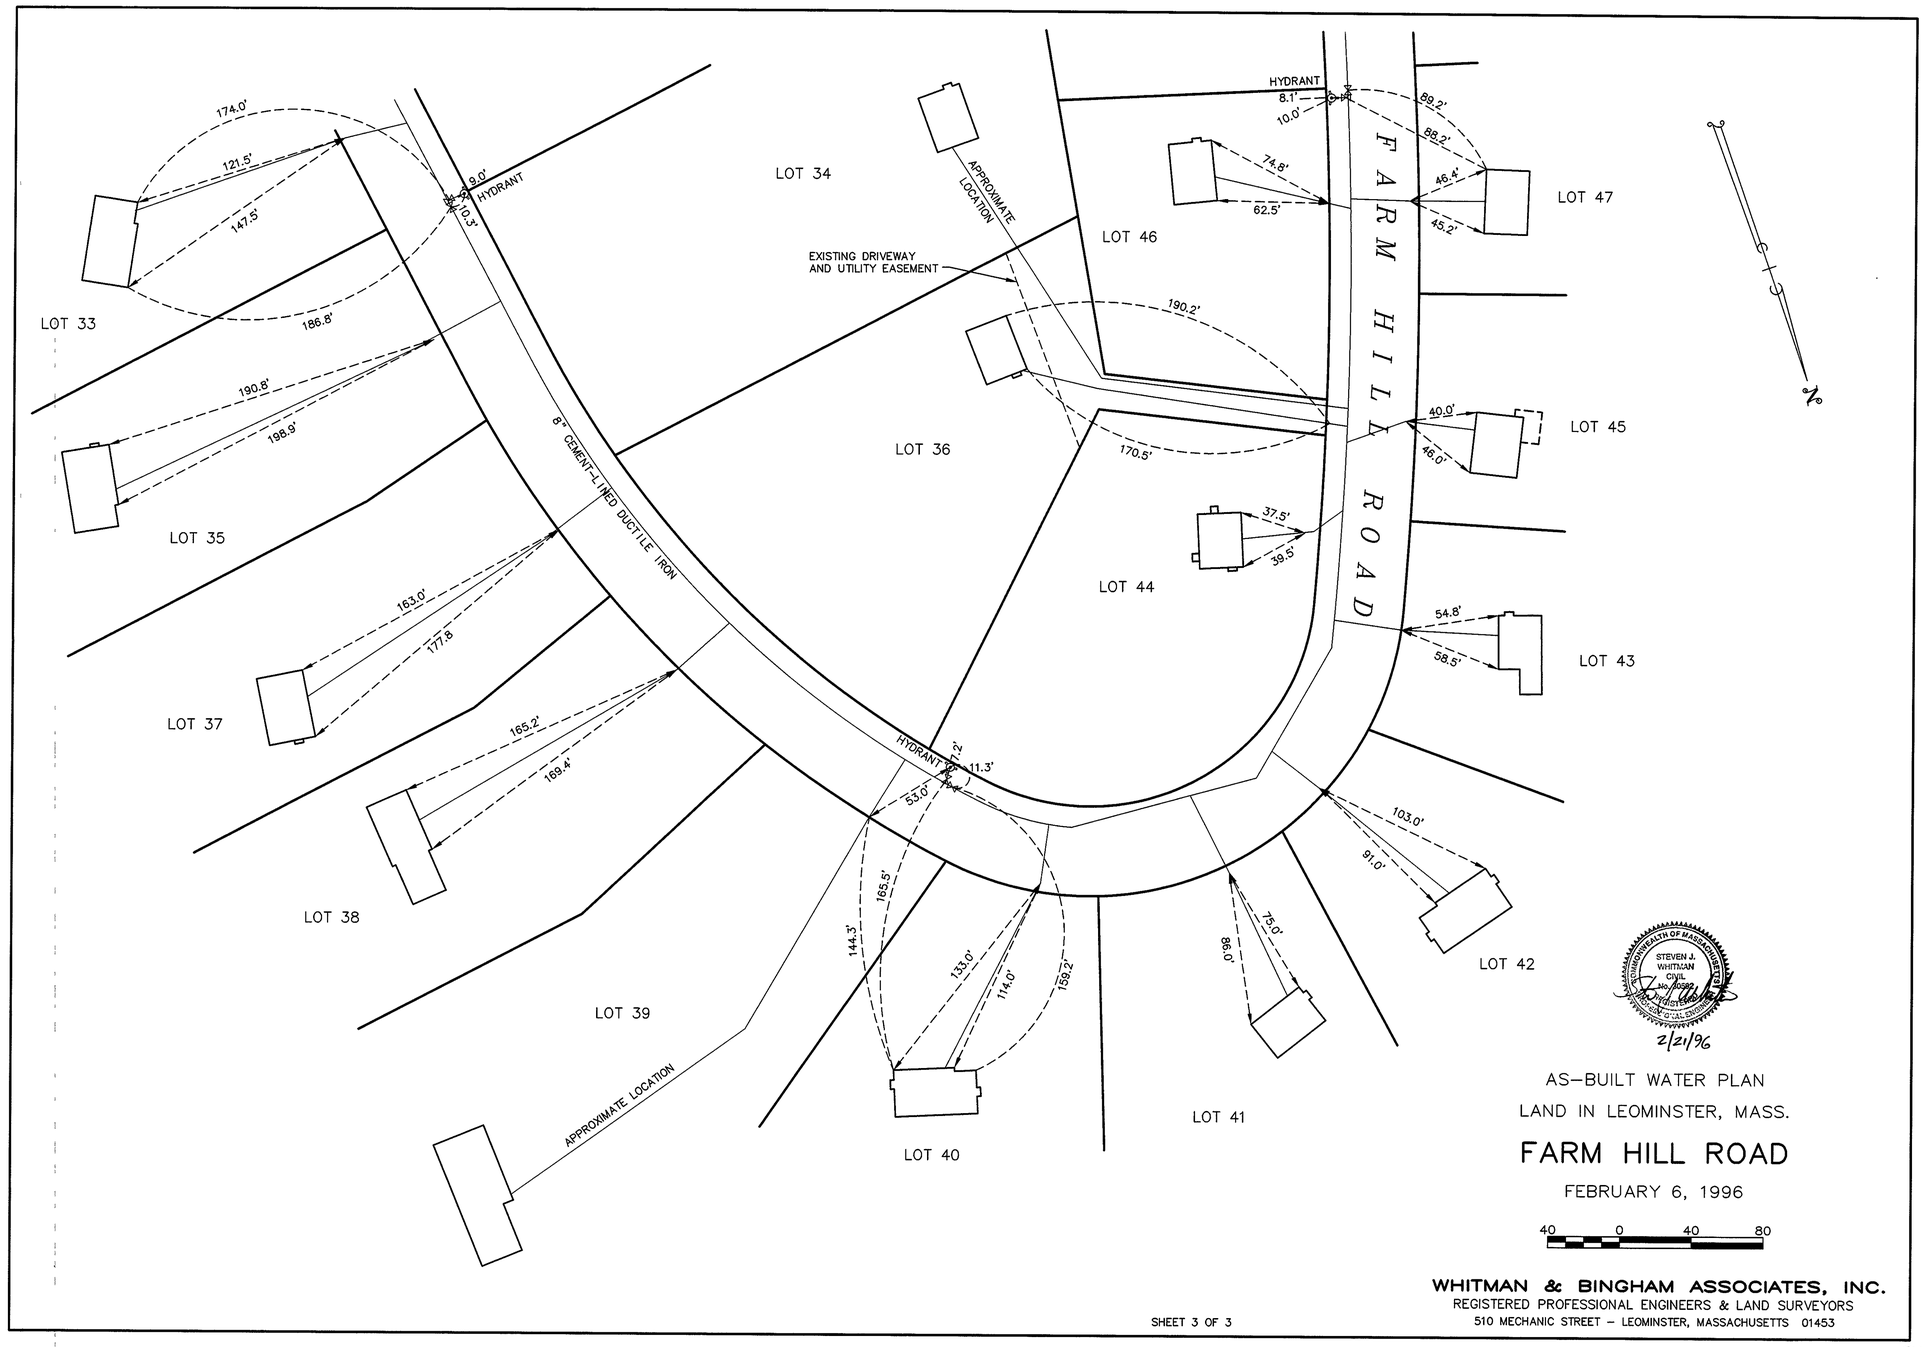

STEVEN J. WHITMAN CIVIL No. 30582 REGISTERED PROFESSIONAL ENGINEER COMMONWEALTH OF MASSACHUSETTS

2/21/96

AS-BUILT WATER PLAN

LAND IN LEOMINSTER, MASS.

FARM HILL ROAD

FEBRUARY 6, 1996

40 0 40 80

WHITMAN & BINGHAM ASSOCIATES, INC.

REGISTERED PROFESSIONAL ENGINEERS & LAND SURVEYORS

510 MECHANIC STREET – LEOMINSTER, MASSACHUSETTS 01453

SHEET 3 OF 3

21-D-7 844