AS-BUILT WATER PLAN
IN
LEOMINSTER, MASSACHUSETTS

PREPARED FOR: SECURED FINANCIAL LIMITED PARTNERSHIP I 14 MONUMENT SQUARE LEOMINSTER, MASSACHUSETTS 01453 TEL:	CALC: JRR	DRWN: JRR
	CHKD: WDH	SCALE: 1" = 40'
	APPD: JMO	DATE: DEC 8, 1997
DWG: BOV-BSCT	HANNIGAN ENGINEERING CIVIL ENGINEERS & LAND SURVEYORS 8 MONUMENT SQUARE LEOMINSTER, MASSACHUSETTS 01453 (508) 534-1234 FAX (508) 534-6060	JOB NO: 1127
SRV: GRJ		SHEET 1 OF 1
FB: 13-155		PLAN NO: B-1-1

BISCUIT HILL DRIVE & JEWEL DRIVE

COMMONWEALTH OF MASSACHUSETTS
WILLIAM D HANNIGAN
CIVIL
12-16-97
PROFESSIONAL ENGINEER

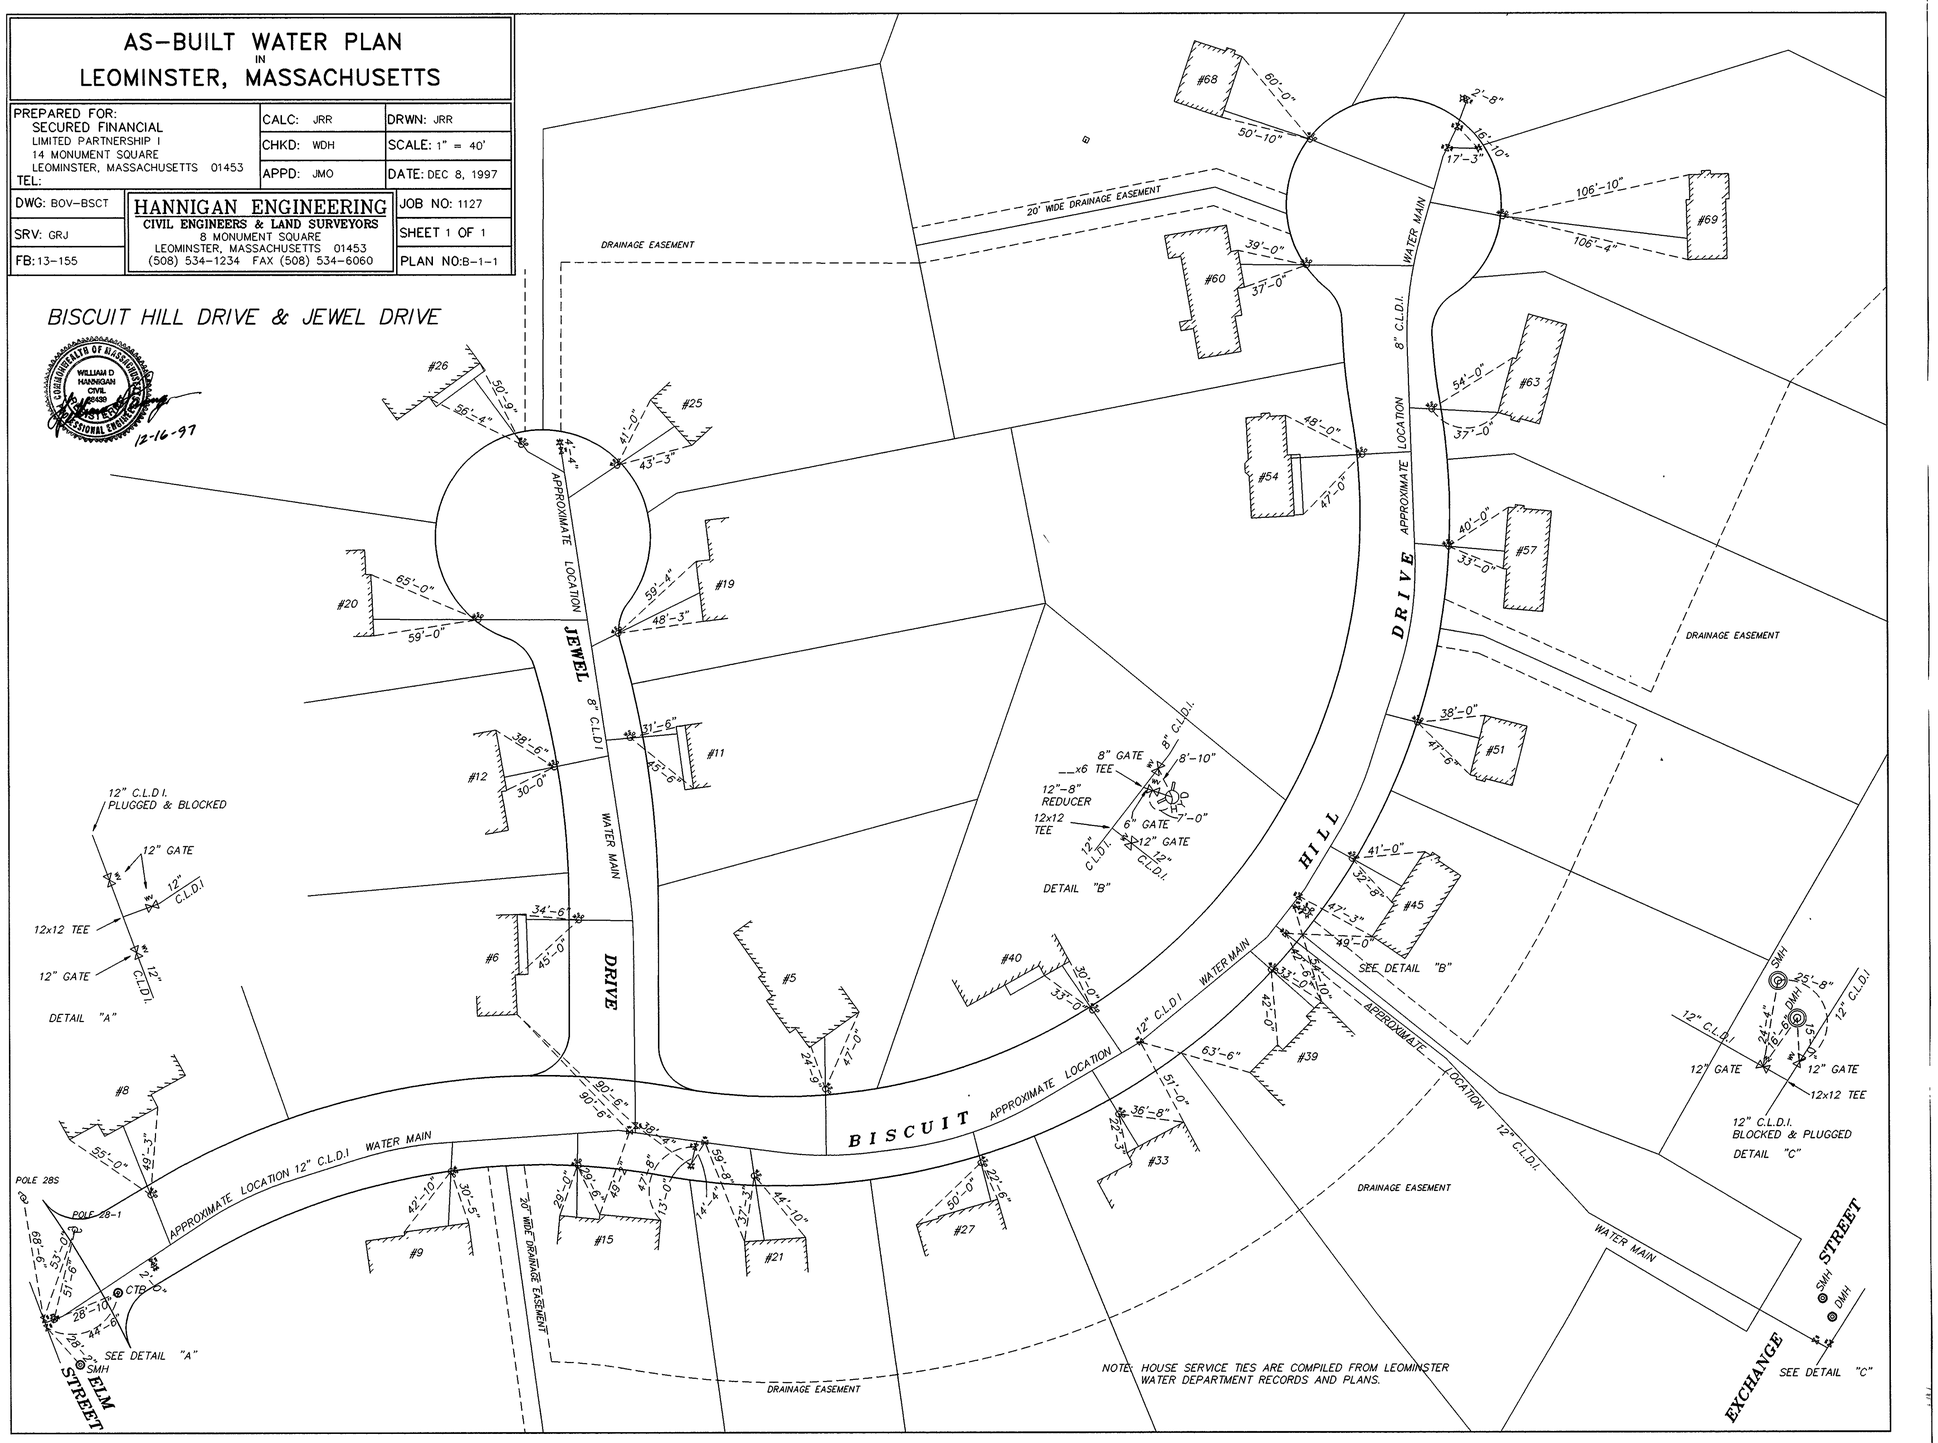

NOTE: HOUSE SERVICE TIES ARE COMPILED FROM LEOMINSTER WATER DEPARTMENT RECORDS AND PLANS.

854