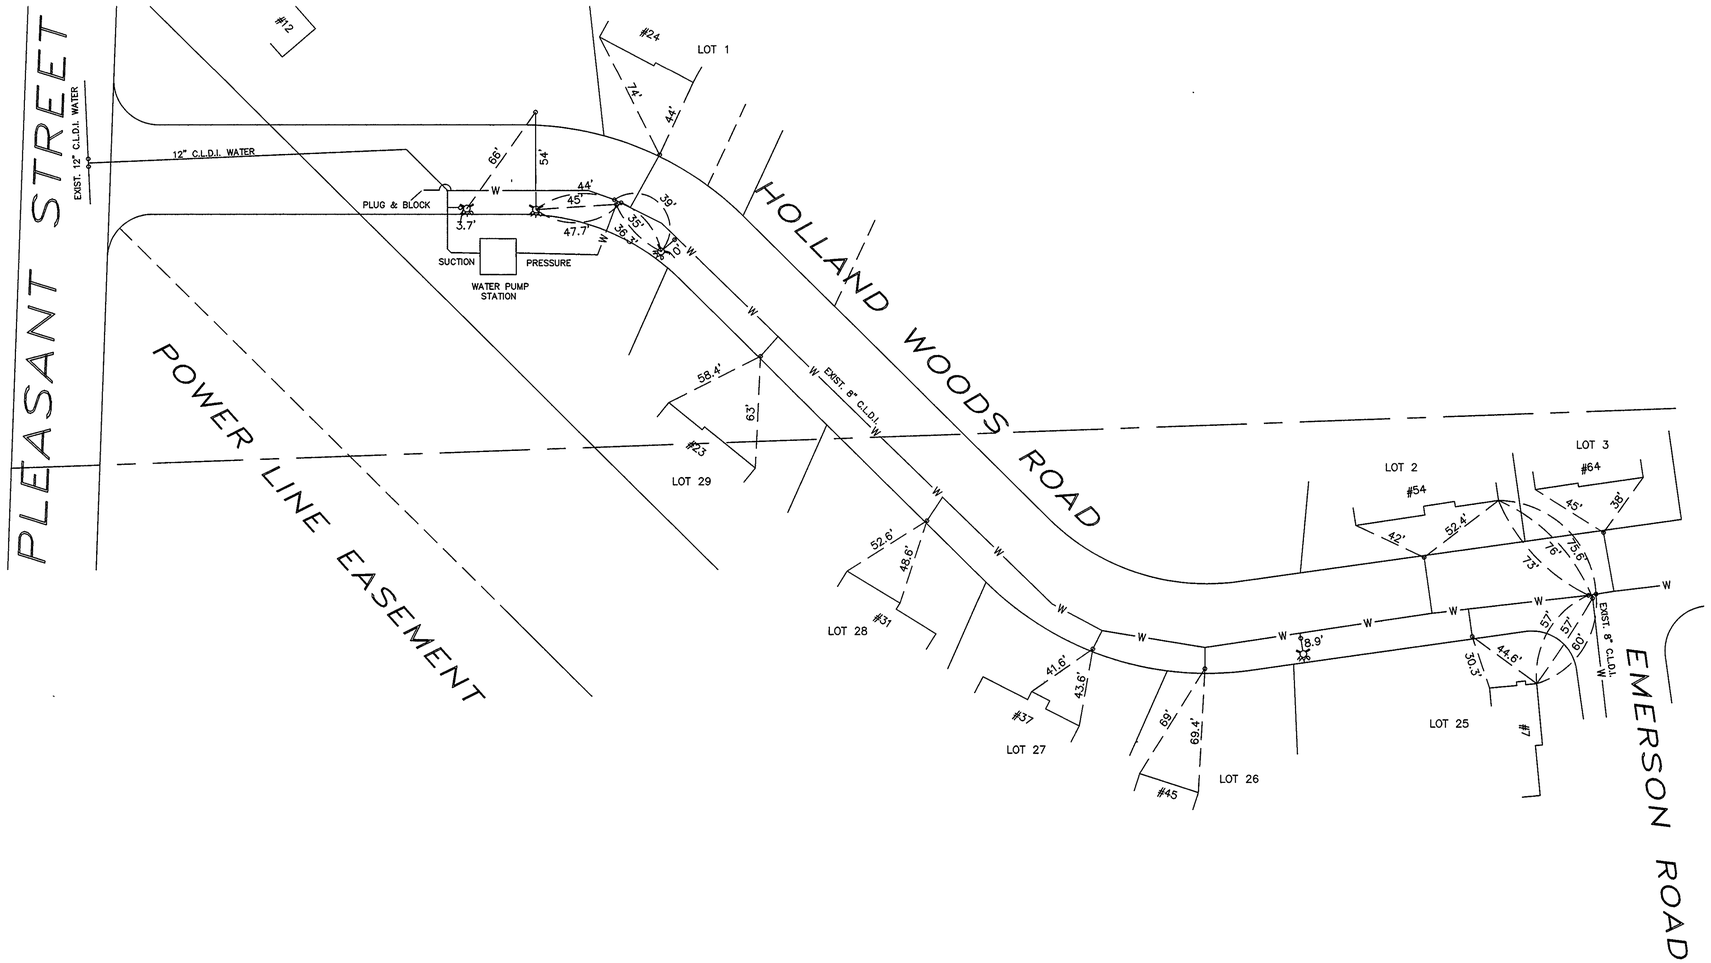

HOLLAND WOODS

AS–BUILT WATER PLAN

IN LEOMINSTER, MASS.

PREPARED FOR

CARTER HILL CAPITAL CORP.

MARCH 16, 1998

40 0 40 80

NOTE: TIES TO SERVICE BOXES SUPPLIED BY LEOMINSTER DEPARTMENT OF PUBLIC WORKS.

LEGEND

- o EXISTING SERVICE BOX
- EXISTING HYDRANT

WHITMAN & BINGHAM ASSOCIATES, INC.
REGISTERED PROFESSIONAL ENGINEERS & LAND SURVEYORS
510 MECHANIC STREET – LEOMINSTER, MASSACHUSETTS 01453

SHEET 1 OF 3

24–D–33A

855