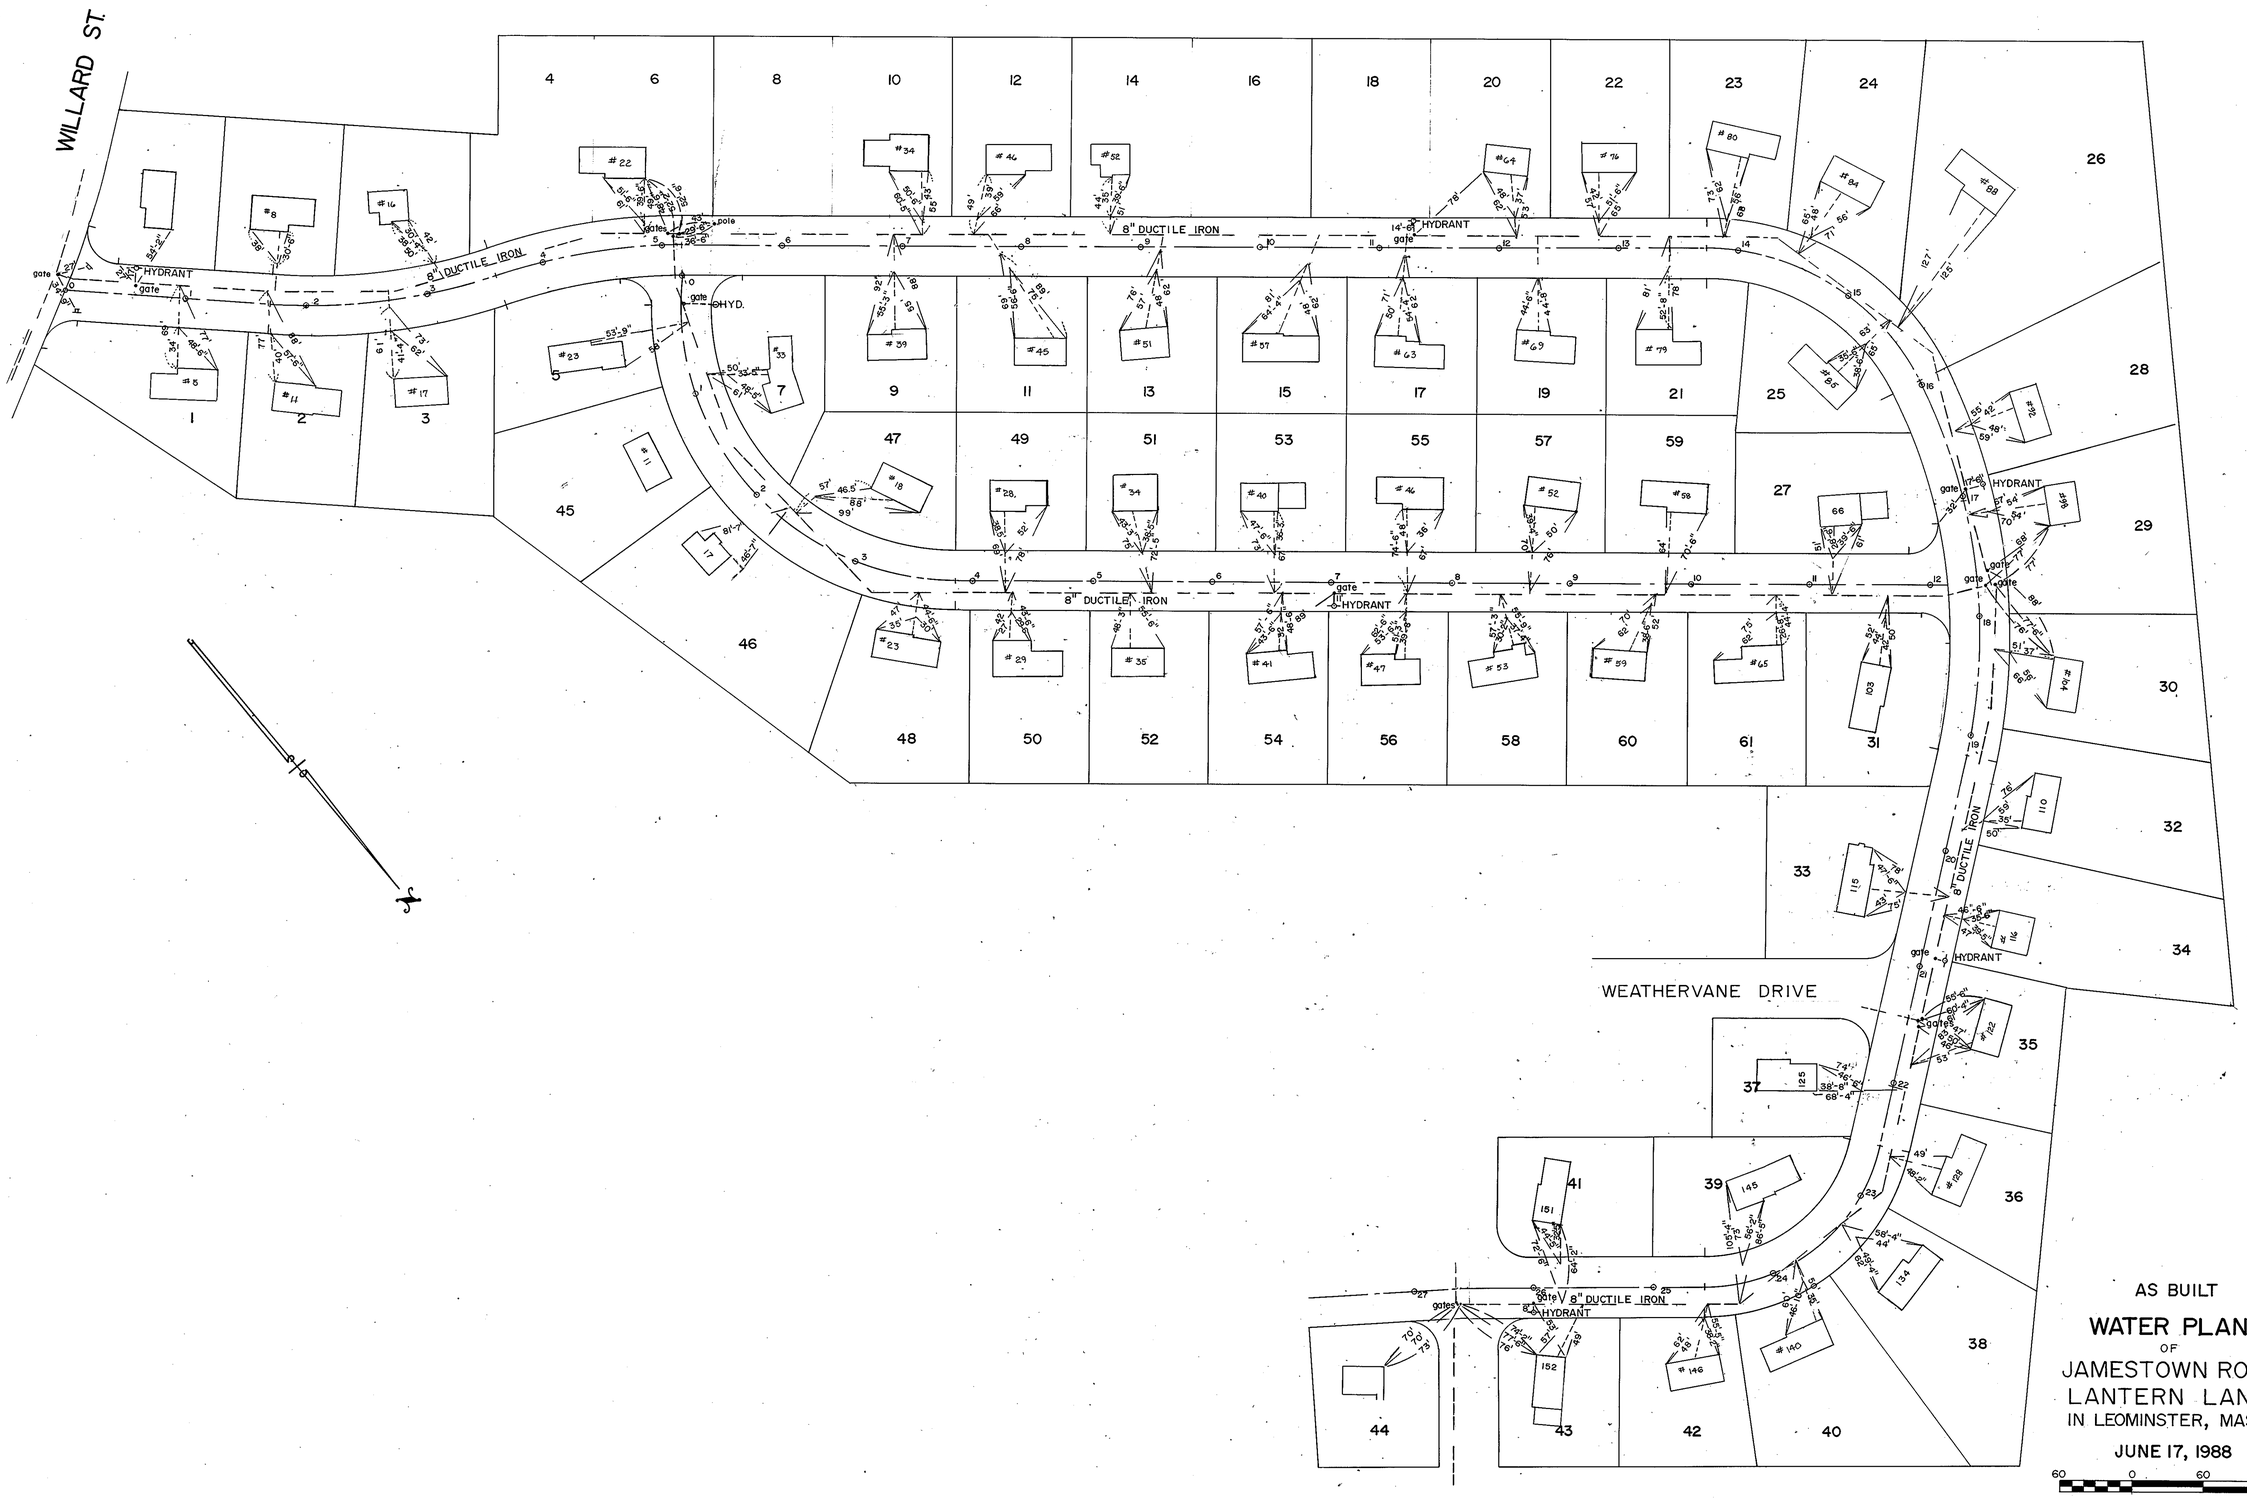
WILLARD ST.
8" DUCTILE IRON
HYDRANT
gate
WEATHERVANE DRIVE
AS BUILT
WATER PLAN
OF
JAMESTOWN ROAD
LANTERN LANE
IN LEOMINSTER, MASS.
JUNE 17, 1988
60 0 60 120
WHITMAN & BINGHAM ASSOC-REG. ENGRS. & SURVEYORS
305 WHITNEY ST. — LEOMINSTER, MASS.