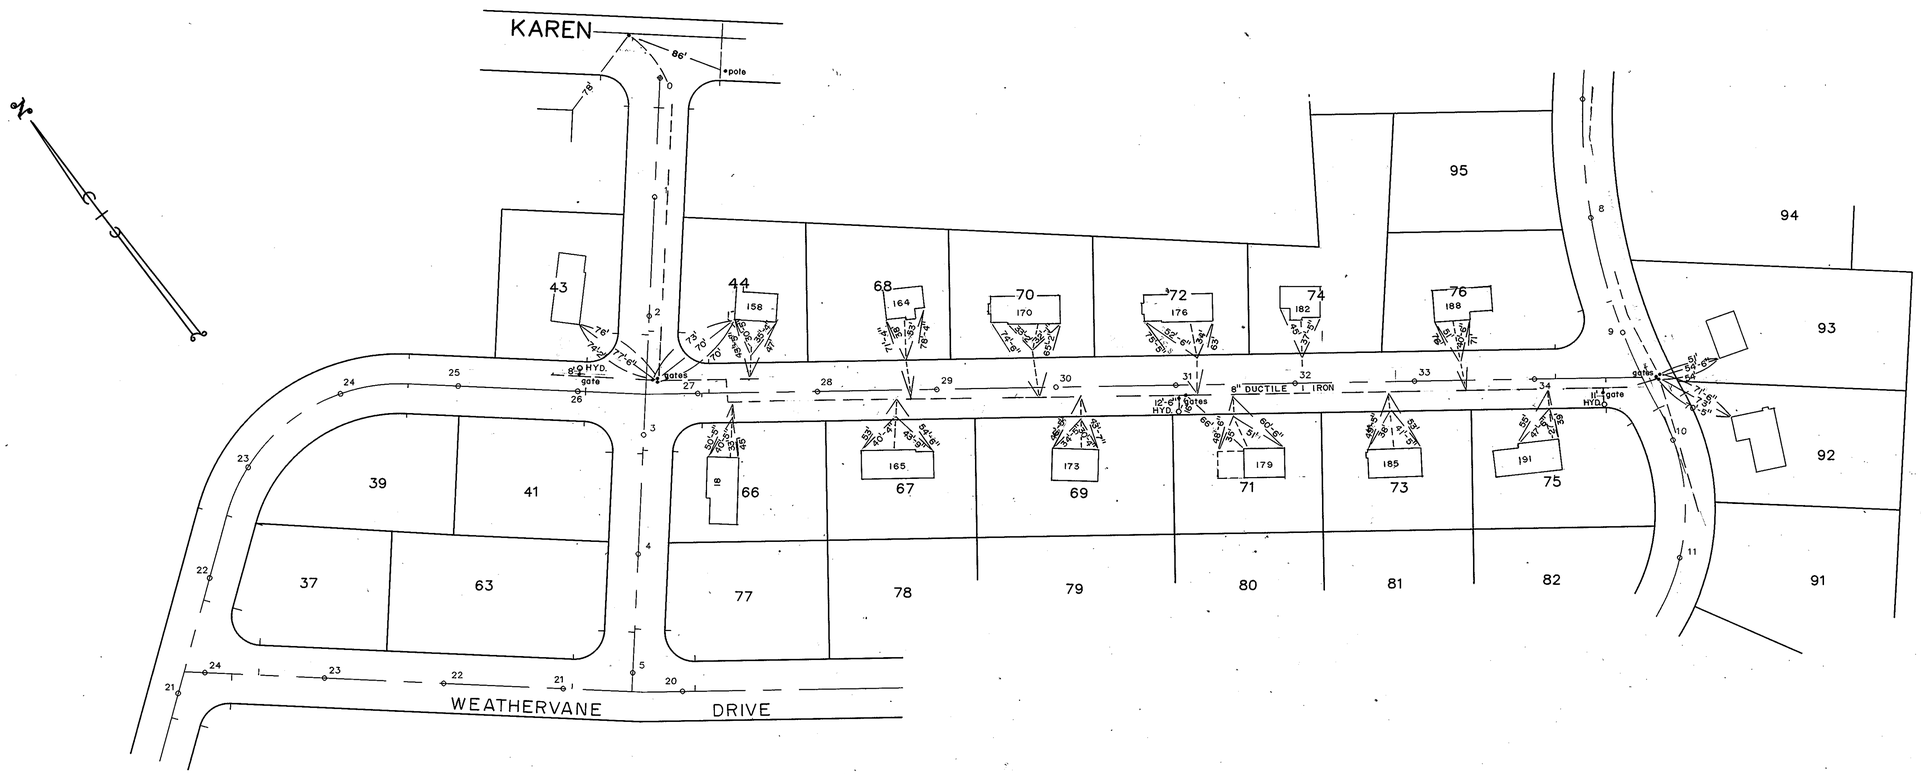

60 0 60 120

PLAN

AS BUILT
WATER PLAN
OF
JAMESTOWN ROAD
CURRIER & IVES ROAD
IN LEOMINSTER, MASS.

JUNE 29, 1990

SCALES AS SHOWN

WHITMAN & BINGHAM ASSOCIATES
305 WHITNEY STREET – LEOMINSTER, MASS. 01453

901