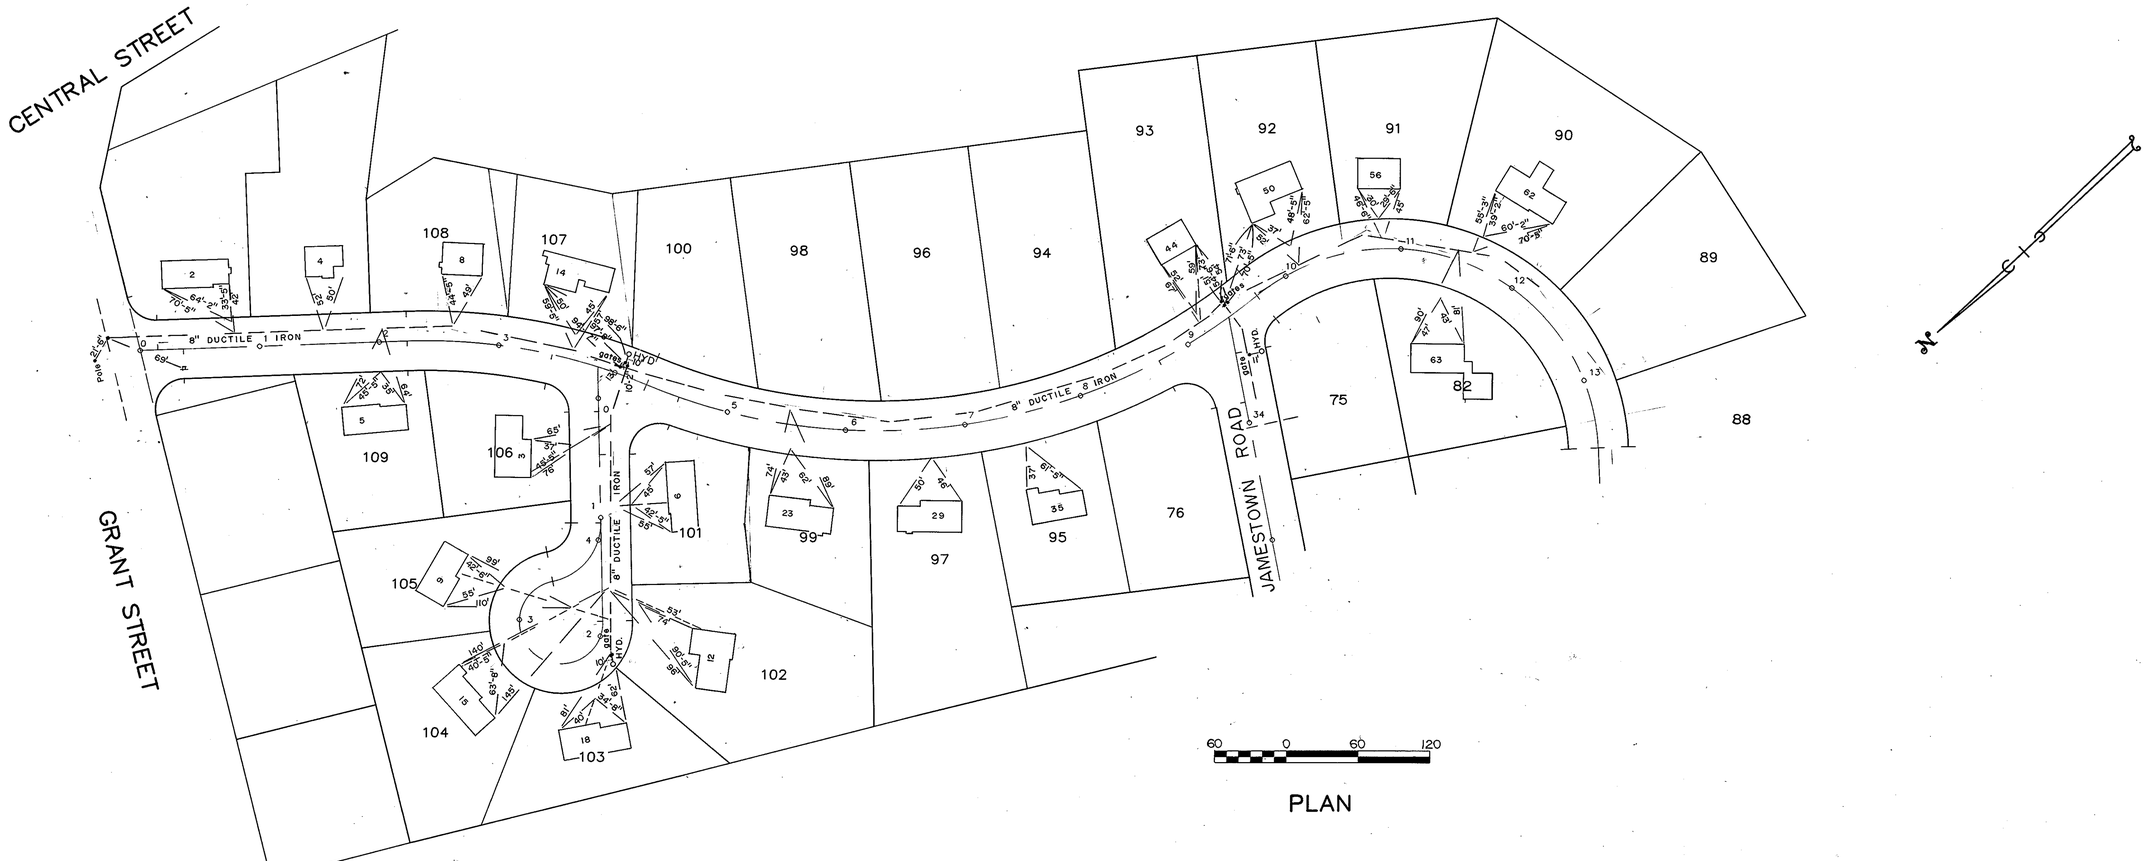

PLAN

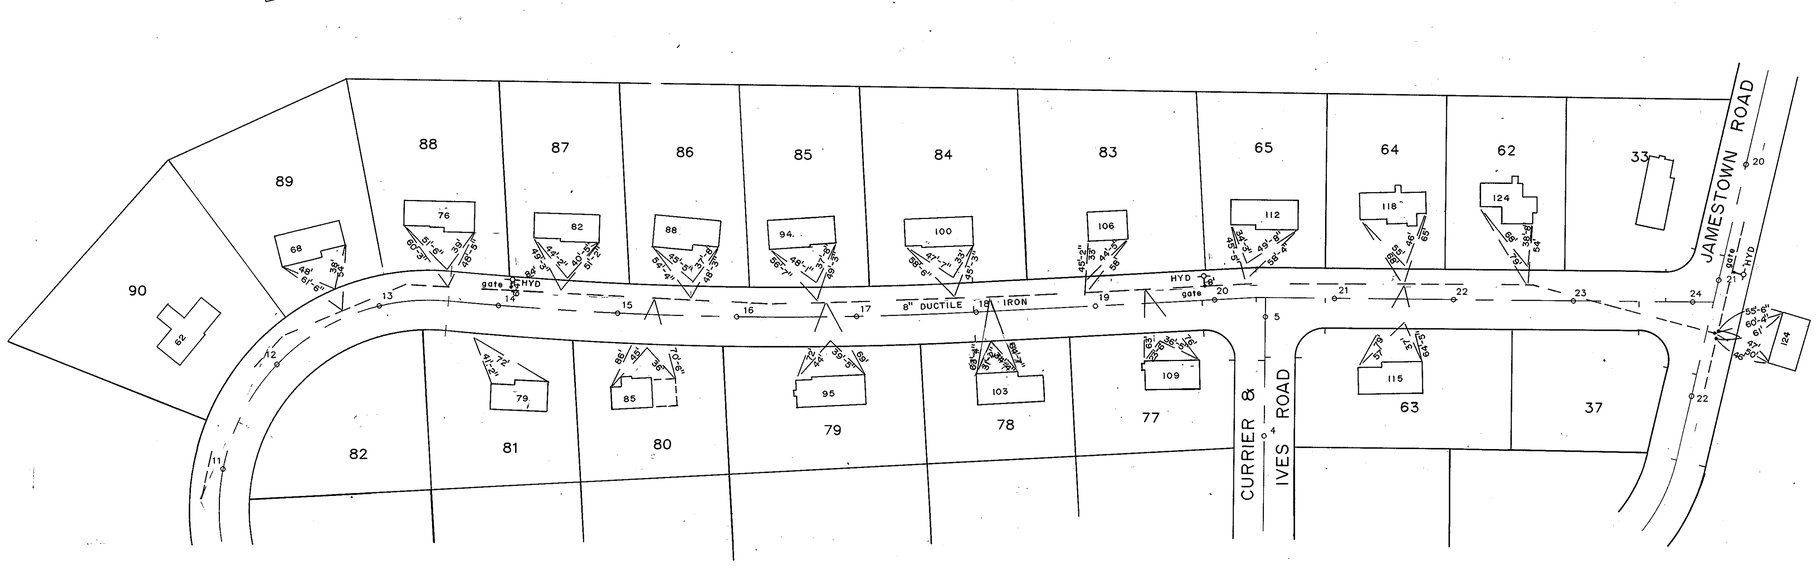

AS BUILT

WATER PLAN

OF

WEATHERVANE DRIVE

POWDER HOUSE LANE

IN LEOMINSTER, MASS.

JUNE 30, 1990

SCALES AS SHOWN

WHITMAN & BINGHAM ASSOCIATES

305 WHITNEY STREET – LEOMINSTER, MASS. 01453

902