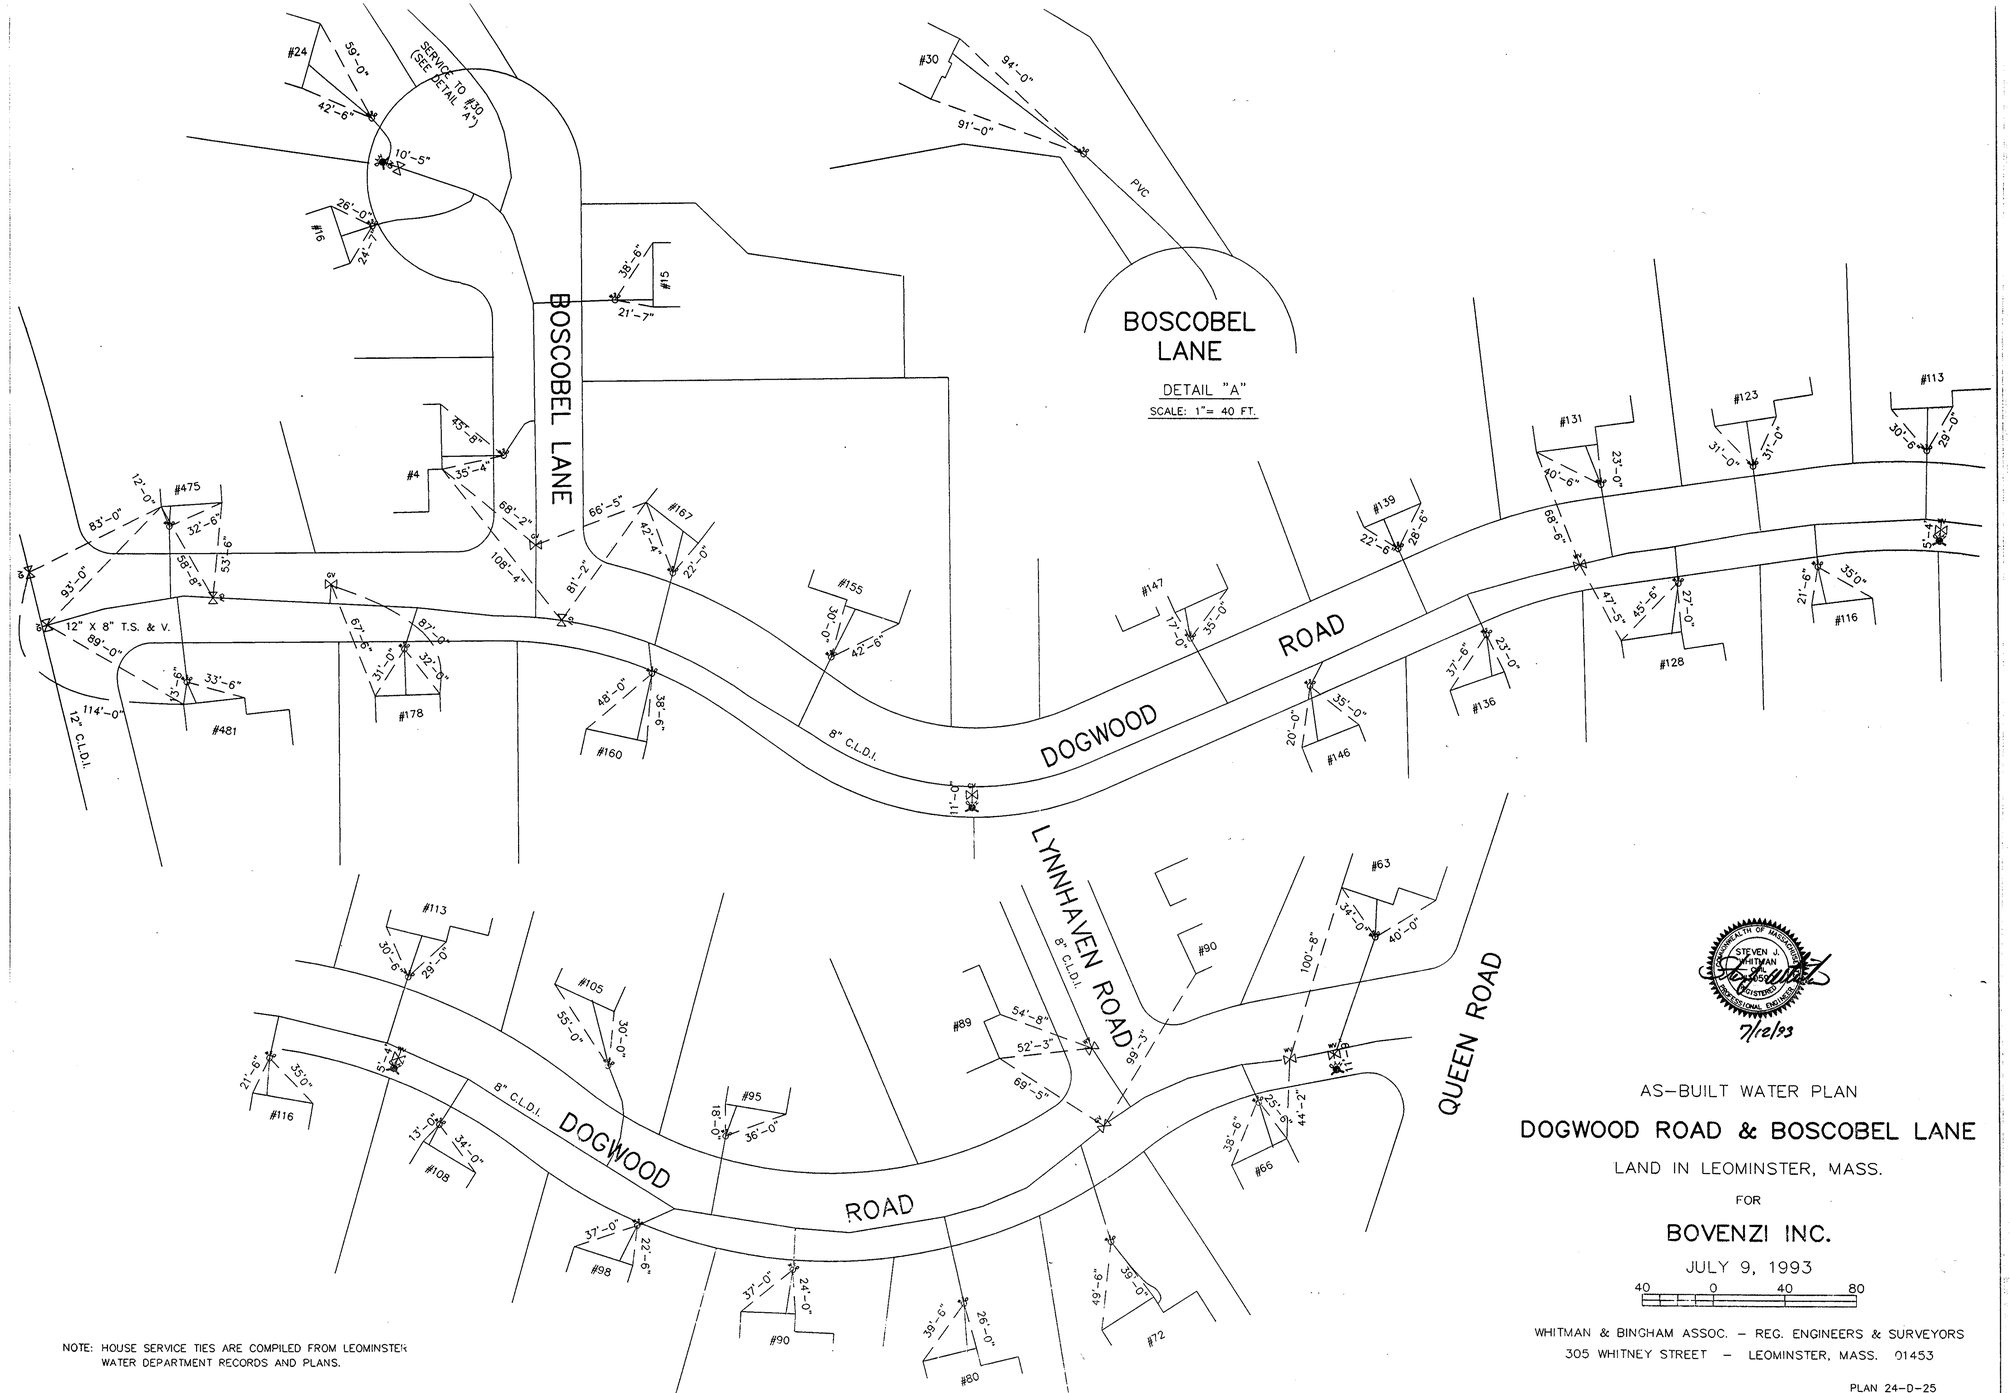

AS-BUILT WATER PLAN

DOGWOOD ROAD & BOSCOBEL LANE

LAND IN LEOMINSTER, MASS.

FOR

BOVENZI INC.

JULY 9, 1993

40 0 40 80

WHITMAN & BINGHAM ASSOC. – REG. ENGINEERS & SURVEYORS
305 WHITNEY STREET – LEOMINSTER, MASS. 01453

PLAN 24-D-25

905

NOTE: HOUSE SERVICE TIES ARE COMPILED FROM LEOMINSTER WATER DEPARTMENT RECORDS AND PLANS.