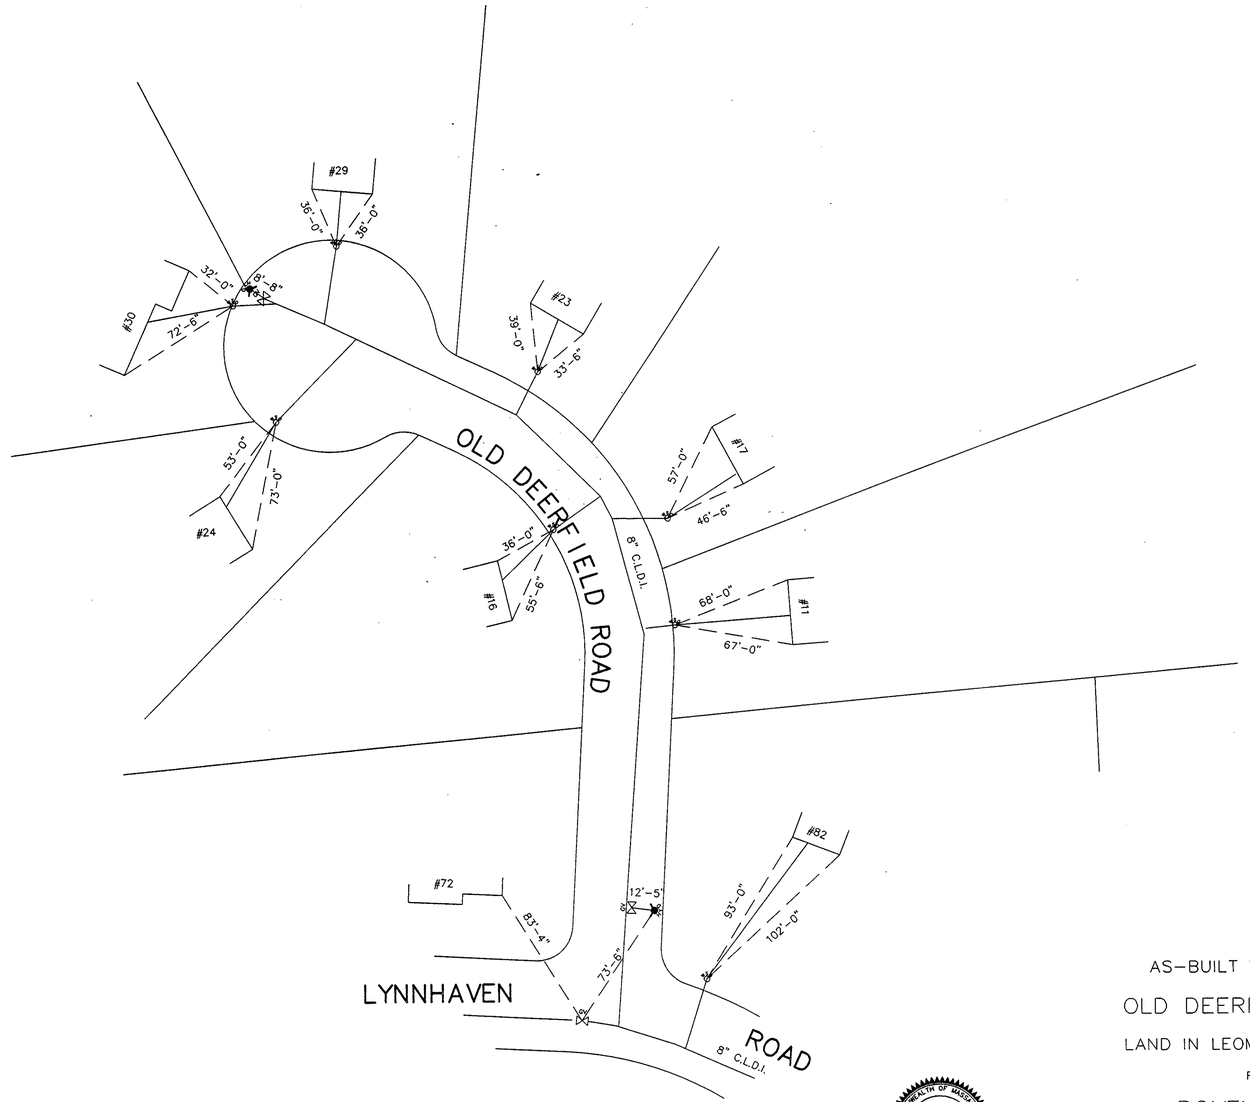

AS-BUILT WATER PLAN

OLD DEERFIELD ROAD

LAND IN LEOMINSTER, MASS.

FOR

BOVENZI INC.

JULY 9, 1993

40 0 40 80

STEVEN J. WHITMAN

7/12/93

WHITMAN & BINGHAM ASSOC. – REG. ENGINEERS & SURVEYORS
305 WHITNEY STREET – LEOMINSTER, MASS. 01453

NOTE: HOUSE SERVICE TIES ARE COMPILED FROM LEOMINSTER WATER DEPARTMENT RECORDS AND PLANS.

906

PLAN 24-D-25