AS-BUILT WATER PLAN

CAPEN WAY, STEUBEN CIRCLE, & LYNNHAVEN RD.

LAND IN LEOMINSTER, MASS.

FOR

BOVENZI, INC.

JULY 9, 1993

40 0 40 80

WHITMAN & BINGHAM ASSOC. – REG. ENGINEERS & SURVEYORS
305 WHITNEY STREET – LEOMINSTER, MASS. 01453

PLAN 24-D-25

COMMONWEALTH OF MASSACHUSETTS
STEVEN J. WHITMAN
No. 6024
REGISTERED PROFESSIONAL ENGINEER

7/12/93

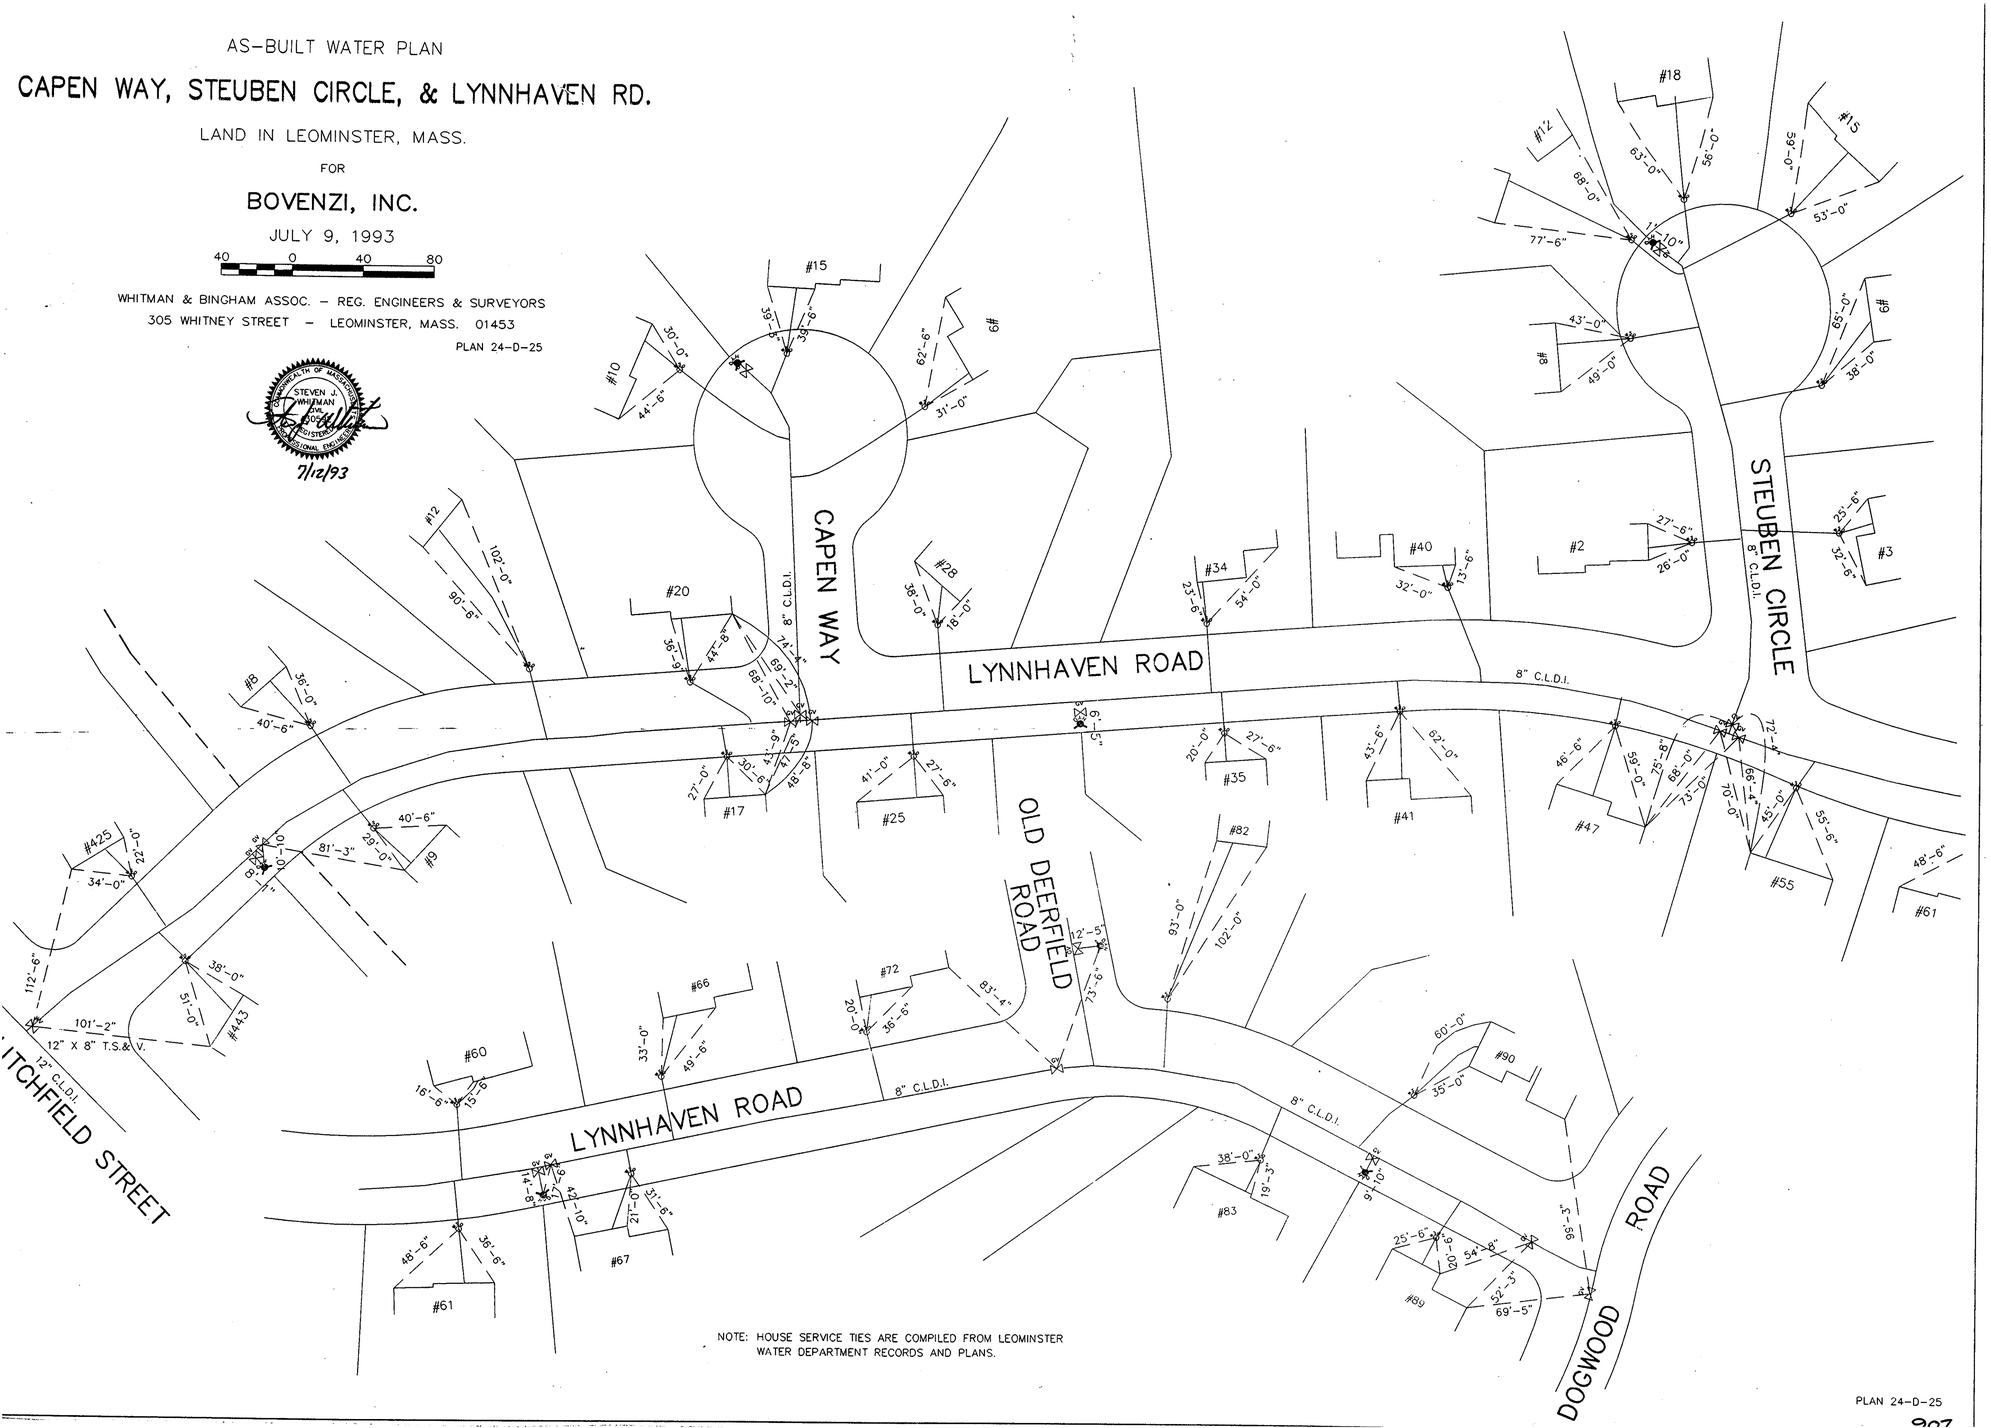

NOTE: HOUSE SERVICE TIES ARE COMPILED FROM LEOMINSTER WATER DEPARTMENT RECORDS AND PLANS.

PLAN 24-D-25